


1 LOCATION OF WATER WELL: County: Kearny Fraction: NW 1/4 SW 1/4 NW 1/4 Section Number: 26 Township Number: T 24 Range Number: R 36 EW

Distance and direction from nearest town or city street address of well if located within city?

1/2 MILE E. of Lakin, Kansas

2 WATER WELL OWNER: Deborah Frederick  
 RR#, St. Address, Box #: Box 984  
 City, State, ZIP Code: Lakin, Kansas 67860  
 Board of Agriculture, Division of Water Resources  
 Application Number:

3 LOCATE WELL'S LOCATION WITH AN "X" IN SECTION BOX:

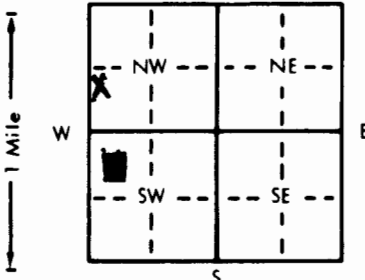

4 DEPTH OF COMPLETED WELL: 15 ft. ELEVATION: NA  
 Depth(s) Groundwater Encountered 1. 11 ft. 2. SWL ft. 3. NA ft.  
 WELL'S STATIC WATER LEVEL: 11 ft. below land surface measured on OCTOBER 30, 1993  
 Pump test data: Well water was NA ft. after NA hours pumping NA gpm  
 Est. Yield NA gpm: Well water was NA ft. after NA hours pumping NA gpm  
 Bore Hole Diameter: NA in. to NA ft., and NA in. to NA ft.  
 WELL WATER TO BE USED AS:  
 1 Domestic was 3 Feedlot 6 Oil field water supply 9 Dewatering 12 Other (Specify below) NA  
 2 Irrigation 4 Industrial 7 Lawn and garden only 10 Monitoring well NA  
 Was a chemical/bacteriological sample submitted to Department? Yes NA No X; If yes, mo/day/yr sample was submitted NA  
 Water Well Disinfected? Yes X No

5 TYPE OF BLANK CASING USED:  
 1 Steel (tin) 3 RMP (SR) 5 Wrought iron 8 Concrete tile CASING JOINTS: Glued NA Clamped X  
 2 PVC 4 ABS 6 Asbestos-Cement 9 Other (specify below) Welded  
 7 Fiberglass Threaded  
 Blank casing diameter: 6 in. to NA ft., Dia: NA in. to NA ft., Dia: NA in. to NA ft.  
 Casing height above land surface: 3 ft., weight: NA lbs./ft. Wall thickness or gauge No. NA  
 TYPE OF SCREEN OR PERFORATION MATERIAL:  
 1 Steel 3 Stainless steel 5 Fiberglass 8 RMP (SR) 11 Other (specify) NA  
 2 Brass 4 Galvanized steel 6 Concrete tile 9 ABS 12 None used (open hole)  
 SCREEN OR PERFORATION OPENINGS ARE:  
 1 Continuous slot 3 Mill slot 5 Gauzed wrapped 8 Saw cut 11 None (open hole)  
 2 Louvered shutter 4 Key punched 7 Torch cut 10 Other (specify) NA  
 SCREEN-PERFORATED INTERVALS: From NA ft. to NA ft., From NA ft. to NA ft., From NA ft. to NA ft.  
 GRAVEL PACK INTERVALS: From NA ft. to NA ft., From NA ft. to NA ft., From NA ft. to NA ft.

6 GROUT MATERIAL: 1 Neat cement 2 Cement grout 3 Bentonite 4 Other  
 Grout Intervals: From 6 ft. to 3 ft., From NA ft. to NA ft., From NA ft. to NA ft.

What is the nearest source of possible contamination:  
 1 Septic tank 4 Lateral lines 7 Pit privy 10 Livestock pens 14 Abandoned water well  
 2 Sewer lines 5 Cess pool 8 Sewage lagoon 11 Fuel storage 15 Oil well/Gas well  
 3 Watertight sewer lines 6 Seepage pit 9 Feedyard 12 Fertilizer storage 16 Other (specify below) Pesticide/Herbicide SPRAYING  
 13 Insecticide storage  
 Direction from well? East NEXT TO → How many feet? NA

FROM	TO	LITHOLOGIC LOG	FROM	TO	PLUGGING INTERVALS
15'	11'	SAND/GRAVEL, CHLORINE			
11'	6'	DIRT/CLAY			
6'	3'	BENTONITE			
3'	0'	FILL DIRT			

7 CONTRACTOR'S OR LANDOWNER'S CERTIFICATION: This water well was (1) constructed, (2) reconstructed, or (3) plugged under my jurisdiction and was completed on (mo/day/year) 3/9/93 and this record is true to the best of my knowledge and belief. Kansas Water Well Contractor's License No. NA This Water Well Record was completed on (mo/day/yr) APRIL 1993 under the business name of Deborah (+/or Robert) FREDERICK by (signature) Deborah Frederick

INSTRUCTIONS: Use typewriter or ball point pen. PLEASE PRESS FIRMLY and PRINT clearly. Please fill in blanks, underline or circle the correct answers. Send top three copies to Kansas Department of Health and Environment, Bureau of Water, Topeka, Kansas 66620-0001. Telephone: 913-296-5545. Send one to WATER WELL OWNER and retain one for your records.  
Deborah Frederick