


1 LOCATION OF WATER WELL: County: Keosau Fraction: SW 1/4 NE 1/4 NW 1/4 Section Number: 27 Township Number: T 24 S Range Number: R 36 E/W

Distance and direction from nearest town or city street address of well if located within city?
In Lakin

2 WATER WELL OWNER: Johanna Schibbelhut
RR#, St. Address, Box #: 210 E Lincoln Board of Agriculture, Division of Water Resources
City, State, ZIP Code: Lakin, KS 67860 Application Number:

3 LOCATE WELL'S LOCATION WITH AN "X" IN SECTION BOX:

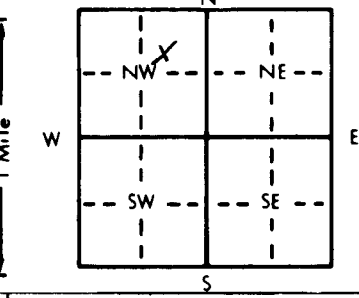

4 DEPTH OF COMPLETED WELL: 22 ft. ELEVATION:

Depth(s) Groundwater Encountered 1. _____ ft. 2. _____ ft. 3. _____ ft.
WELL'S STATIC WATER LEVEL: 14 ft. below land surface measured on mo/day/yr
Pump test data: Well water was _____ ft. after _____ hours pumping _____ gpm
Est. Yield _____ gpm: Well water was _____ ft. after _____ hours pumping _____ gpm
Bore Hole Diameter _____ in. to _____ ft., and _____ in. to _____ ft.
WELL WATER TO BE USED AS:
1 Domestic 3 Feedlot 6 Oil field water supply 9 Dewatering 11 Injection well
2 Irrigation 4 Industrial 7 Lawn and garden only 10 Monitoring well 12 Other (Specify below)
Was a chemical/bacteriological sample submitted to Department? Yes _____ No 5; If yes, mo/day/yr sample was submitted _____
Water Well Disinfected? Yes No

5 TYPE OF CASING USED: 1 Steel 3 RMP (SR) 5 Wrought iron 8 Concrete tile CASING JOINTS: Glued _____ Clamped _____
2 PVC 4 ABS 6 Asbestos-Cement 9 Other (specify below) Welded _____
7 Fiberglass Threaded _____

Blank casing diameter _____ in. to _____ ft., Dia _____ in. to _____ ft., Dia _____ in. to _____ ft.
Casing height above land surface _____ in., weight _____ lbs./ft. Wall thickness or gauge No. _____

TYPE OF SCREEN OR PERFORATION MATERIAL:
1 Steel 3 Stainless steel 5 Fiberglass 7 PVC 10 Asbestos-cement
2 Brass 4 Galvanized steel 6 Concrete tile 8 RMP (SR) 11 Other (specify) NA
12 None used (open hole)

SCREEN OR PERFORATION OPENINGS ARE:
1 Continuous slot 3 Mill slot 5 Gauzed wrapped 8 Saw cut 11 None (open hole)
2 Louvered shutter 4 Key punched 6 Wire wrapped 9 Drilled holes
7 Torch cut 10 Other (specify) NA

SCREEN-PERFORATED INTERVALS: From _____ NA ft. to _____ NA ft., From _____ ft. to _____ ft.
GRAVEL PACK INTERVALS: From _____ ft. to _____ ft., From _____ ft. to _____ ft.

6 GROUT MATERIAL: 1 Neat cement 2 Cement grout 3 Bentonite 4 Other _____
Grout Intervals: From _____ 6 ft. to _____ 3 ft., From _____ ft. to _____ ft., From _____ ft. to _____ ft.

What is the nearest source of possible contamination:
1 Septic tank 4 Lateral lines 7 Pit privy 10 Livestock pens 14 Abandoned water well
2 Sewer lines 5 Cess pool 8 Sewage lagoon 11 Fuel storage 15 Oil well/Gas well
3 Watertight sewer lines 6 Seepage pit 9 Feedyard 12 Fertilizer storage 16 Other (specify below)
13 Insecticide storage _____ NONE

Direction from well? How many feet?

FROM	TO	LITHOLOGIC LOG	FROM	TO	PLUGGING INTERVALS
<u>22'</u>	<u>14'</u>	<u>Sand</u>			
<u>14'</u>	<u>6'</u>	<u>Silt/Clay</u>			
<u>6'</u>	<u>3'</u>	<u>Bentonite</u>			
<u>3'</u>	<u>0'</u>	<u>Silt</u>			

7 CONTRACTOR'S OR LANDOWNER'S CERTIFICATION: This water well was (1) constructed, (2) reconstructed, or (3) plugged under my jurisdiction and was completed on (mo/day/year) April 18, 93 and this record is true to the best of my knowledge and belief. Kansas Water Well Contractor's License No. _____ This Water Well Record was completed on (mo/day/yr) April 18, 1993 under the business name of _____ by (signature) Johanna Schibbelhut