


1 LOCATION OF WATER WELL: Fraction NE 1/4 NE 1/4 NW 1/4 Section Number 27 Township Number T 24 S Range Number R 36 E/W
 County: Hearny

Distance and direction from nearest town or city street address of well if located within city?

108 N Kingman

2 WATER WELL OWNER: Pearl Crain
 RR#, St. Address, Box #: PO Box 13
 City, State, ZIP Code: Lakin KS 67860
 Board of Agriculture, Division of Water Resources
 Application Number:

3 LOCATE WELL'S LOCATION WITH AN "X" IN SECTION BOX:

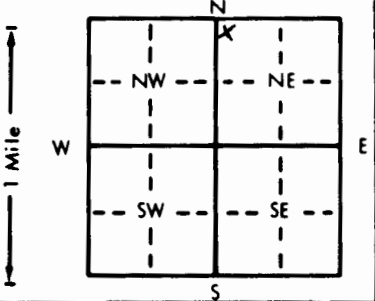

4 DEPTH OF COMPLETED WELL: 18 ft. ELEVATION:ft.
 Depth(s) Groundwater Encountered 1.ft. 2.ft. 3.ft.
 WELL'S STATIC WATER LEVEL: Dry ft. below land surface measured on mo/day/yr 3-3-94
 Pump test data: Well water wasft. after hours pumping gpm
 Est. Yield gpm: Well water wasft. after hours pumping gpm
 Bore Hole Diameter wasin. toft., andin. toft.
 WELL WATER TO BE USED AS:
 1 Domestic 3 Feedlot 6 Oil field water supply 9 Dewatering 12 Other (Specify below)
 2 Irrigation 4 Industrial 7 Lawn and garden only 10 Monitoring well
 Was a chemical/bacteriological sample submitted to Department? Yes.....No...X.....; If yes, mo/day/yr sample was submitted
 Water Well Disinfected? Yes No

5 TYPE OF BLANK CASING USED:
 1 Steel 2 PVC 3 RMP (SR) 4 ABS 5 Wrought iron 6 Asbestos-Cement 7 Fiberglass 8 Concrete tile 9 Other (specify below) CASING JOINTS: Glued Clamped
 Blank casing diameter4 in. toft., Diain. toft., Diain. toft.
 Casing height above land surface: 36 in., weight lbs./ft. Wall thickness or gauge No.
 TYPE OF SCREEN OR PERFORATION MATERIAL:
 1 Steel 2 Brass 3 Stainless steel 4 Galvanized steel 5 Fiberglass 6 Concrete tile 7 PVC 8 RMP (SR) 9 ABS 10 Asbestos-cement 11 Other (specify) NA
 SCREEN OR PERFORATION OPENINGS ARE:
 1 Continuous slot 2 Louvered shutter 3 Mill slot 4 Key punched 5 Gauzed wrapped 6 Wire wrapped 7 Torch cut 8 Saw cut 9 Drilled holes 10 Other (specify) NA 11 None (open hole)
 SCREEN-PERFORATED INTERVALS: FromNA ft. toNA ft., Fromft. toft.
 GRAVEL PACK INTERVALS: Fromft. toft., Fromft. toft.

6 GROUT MATERIAL: 1 Neat cement 2 Cement grout 3 Bentonite 4 Other
 Grout Intervals: From 3 ft. to 0 ft., Fromft. toft., Fromft. toft.
 What is the nearest source of possible contamination:
 2 Sewer lines 5 Cess pool 8 Sewage lagoon 12 Fertilizer storage 16 Other (specify below)
 1 Septic tank 4 Lateral lines 7 Pit privy 9 Feedyard 10 Livestock pens 11 Fuel storage 13 Insecticide storage 14 Abandoned water well 15 Oil well/Gas well
 3 Watertight sewer lines 6 Seepage pit

FROM	TO	LITHOLOGIC LOG	FROM	TO	PLUGGING INTERVALS
			18'	17'	Sand
			17'	3'	Dirt/Clay
			3'	0'	Cement

7 CONTRACTOR'S OR LANDOWNER'S CERTIFICATION: This water well was (1) constructed, (2) reconstructed, or 3 plugged under my jurisdiction and was completed on (mo/day/year) 3-12-94 and this record is true to the best of my knowledge and belief. Kansas Water Well Contractor's License No. This Water Well Record was completed on (mo/day/yr) 3-14-94 under the business name of by (signature) Pearl E. Crain

INSTRUCTIONS: Use typewriter or ball point pen. PLEASE PRESS FIRMLY and PRINT clearly. Please fill in blanks, underline or circle the correct answers. Send top three copies to Kansas Department of Health and Environment, Bureau of Water, Topeka, Kansas 66620-0001. Telephone: 913-296-5545. Send one to WATER WELL OWNER and retain one for your records.