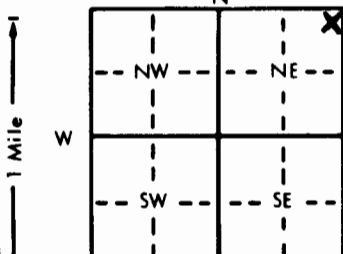


1 LOCATION OF WATER WELL:	Fraction	Section Number	Township Number	Range Number
County: Kearny	NE 1/4 NE 1/4 NE 1/4	29	T 24 S	R 36 E N

Distance and direction from nearest town or city street address of well if located within city?

1 W of Lakin, KS--

2 WATER WELL OWNER:	Colorado Interstate Gas Co.	(Lakin Compressor Station Water Well #7)
RR#, St. Address, Box # :	P.O. Box 1087	Board of Agriculture, Division of Water Resources
City, State, ZIP Code :	Colorado Springs, Colorado 80944	Application Number: 34750

3 LOCATE WELL'S LOCATION WITH AN "X" IN SECTION BOX:	4 DEPTH OF COMPLETED WELL... 620... ft. ELEVATION:
	Depth(s) Groundwater Encountered 1... 134... ft. 2... ft. 3... ft.
	WELL'S STATIC WATER LEVEL ... 134... ft. below land surface measured on mo/day/yr ... 09-23-91
	Pump test data: Well water was ... 310... ft. after ... 24... hours pumping ... 135... gpm
	Est. Yield ... 135... gpm: Well water was ... ft. after ... hours pumping ... gpm
	Bore Hole Diameter ... 15 1/2... in. to ... 620... ft., and ... in. to ... ft.
	WELL WATER TO BE USED AS: 5 Public water supply 8 Air conditioning 11 Injection well
	1 Domestic 3 Feedlot 6 Oil field water supply 9 Dewatering 12 Other (Specify below)
	2 Irrigation 4 Industrial 7 Lawn and garden only 10 Monitoring well
	Was a chemical/bacteriological sample submitted to Department? Yes... No... X...; If yes, mo/day/yr sample was submitted
	Water Well Disinfected? Yes X No

5 TYPE OF BLANK CASING USED:	5 Wrought iron	8 Concrete tile	CASING JOINTS: Glued... Clamped...
1 Steel	3 RMP (SR)	6 Asbestos-Cement	9 Other (specify below)
2 PVC	4 ABS	7 Fiberglass	Welded... X... Threaded...
Blank casing diameter ... 8 5/8... in. to ... 608... ft., Dia ... in. to ... ft., Dia ... in. to ... ft.			
Casing height above land surface ... 36... in., weight ... 28.55... lbs./ft. Wall thickness or gauge No. ... 322			
TYPE OF SCREEN OR PERFORATION MATERIAL:	7 PVC	10 Asbestos-cement	
1 Steel	3 Stainless steel	5 Fiberglass	8 RMP (SR)
2 Brass	4 Galvanized steel	6 Concrete tile	9 ABS
SCREEN OR PERFORATION OPENINGS ARE:	5 Gauzed wrapped	8 Saw cut	11 None (open hole)
1 Continuous slot	3 Mill slot	6 Wire wrapped	9 Drilled holes
2 Louvered shutter	4 Key punched	7 Torch cut	10 Other (specify)
SCREEN-PERFORATED INTERVALS: From ... 362... ft. to ... 382... ft., From ... 390... ft. to ... 410... ft.			
From ... 530... ft. to ... 550... ft., From ... 568... ft. to ... 588... ft.			
GRAVEL PACK INTERVALS: From ... 310... ft. to ... 620... ft., From ... ft. to ... ft.			
From ... ft. to ... ft., From ... ft. to ... ft.			

6 GROUT MATERIAL:	1 Neat cement	2 Cement grout	3 Bentonite	4 Other ... Bentonite Grout
Grout Intervals: From ... 5... ft. to ... 310... ft., From ... ft. to ... ft., From ... ft. to ... ft.				
What is the nearest source of possible contamination:	10 Livestock pens	14 Abandoned water well		
1 Septic tank	4 Lateral lines	7 Pit privy	11 Fuel storage	15 Oil well/Gas well
2 Sewer lines	5 Cess pool	8 Sewage lagoon	12 Fertilizer storage	16 Other (specify below)
3 Watertight sewer lines	6 Seepage pit	9 Feedyard	13 Insecticide storage	
Direction from well? Southwest			How many feet? 30	

FROM	TO	LITHOLOGIC LOG	FROM	TO	PLUGGING INTERVALS
0	2	Top soil			
2	42	Sandy Clay			
42	53	Sand			
53	63	Clay			
63	87	Sand			
87	127	Clay			
127	146	Sand			
146	402	Clay and Shale			
402	409	Sand			
409	539	Clay and Shale			
539	543	Sand			
543	566	Clay			
566	591	Sand			
591	620	Red Clay			

7 CONTRACTOR'S OR LANDOWNER'S CERTIFICATION: This water well was (1) constructed, (2) reconstructed, or (3) plugged under my jurisdiction and was completed on (mo/day/year) ... 09-23-91 ... and this record is true to the best of my knowledge and belief. Kansas Water Well Contractor's License No. KWWCL-430 ... This Water Well Record was completed on (mo/day/yr) ... 09-23-91 ... under the business name of Howard Drlg. Co. Box 806 Beaver, OK73932 by (signature) <i>Howard Drlg. Co.</i>
--

INSTRUCTIONS: Use typewriter or ball point pen. PLEASE PRESS FIRMLY and PRINT clearly. Please fill in blanks, underline or circle the correct answers. Send top three copies to Kansas Department of Health and Environment, Bureau of Water, Topeka, Kansas 66620-0001. Telephone: 913-296-5545. Send one to WATER WELL OWNER and retain one for your records.