


1 LOCATION OF WATER WELL: Fraction NW 1/4 NW 1/4 NE 1/4 Section Number 33 Township Number T 24 S Range Number R 36 E/W

Distance and direction from nearest town or city street address of well if located within city?  
 2 1/4 miles Southwest of Lakin, KS

2 WATER WELL OWNER: Hedge 1-32 Warrior Drilling  
 RR#, St. Address, Box #: Box 240 Board of Agriculture, Division of Water Resources  
 City, State, ZIP Code: Hosington, KS 67544 Application Number: T88-335

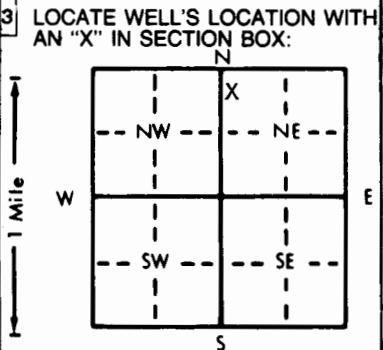

4 DEPTH OF COMPLETED WELL: 140 ft. ELEVATION: ... ft.

Depth(s) Groundwater Encountered 1. 120 ft. 2. ... ft. 3. ... ft.

WELL'S STATIC WATER LEVEL: 20 ft. below land surface measured on mo/day/yr 7-12-88

Pump test data: Well water was 80 ft. after 2 hours pumping 50 gpm

Est. Yield: 55 gpm: Well water was ... ft. after ... hours pumping ... gpm

Bore Hole Diameter: 9 in. to 140 ft., and ... in. to ... ft.

WELL WATER TO BE USED AS:

5 Public water supply	8 Air conditioning	11 Injection well
1 Domestic	3 Feedlot	6 Oil field water supply
2 Irrigation	4 Industrial	7 Lawn and garden only
		10 Observation well
		12 Other (Specify below)

Was a chemical/bacteriological sample submitted to Department? Yes... No ; If yes, mo/day/yr sample was submitted

Water Well Disinfected? Yes  No

5 TYPE OF BLANK CASING USED:

1 Steel	3 RMP (SR)	5 Wrought iron	8 Concrete tile	CASING JOINTS: Glued <input checked="" type="checkbox"/> Clamped ...
2 PVC	4 ABS	6 Asbestos-Cement	9 Other (specify below)	Welded ...
		7 Fiberglass		Threaded ...

Blank casing diameter: 5 in. to 0-60 ft., Dia. ... in. to ... ft., Dia. ... in. to ... ft.

Casing height above land surface: 14 in., weight 200 lbs./ft. Wall thickness or gauge No. 0.265

TYPE OF SCREEN OR PERFORATION MATERIAL:

1 Steel	3 Stainless steel	5 Fiberglass	8 RMP (SR)	10 Asbestos-cement
2 Brass	4 Galvanized steel	6 Concrete tile	9 ABS	11 Other (specify) ...
				12 None used (open hole)

SCREEN OR PERFORATION OPENINGS ARE:

1 Continuous slot	3 Mill slot	5 Gauzed wrapped	8 Saw cut	11 None (open hole)
2 Louvered shutter	4 Key punched	6 Wire wrapped	9 Drilled holes	
		7 Torch cut	10 Other (specify) ...	

SCREEN-PERFORATED INTERVALS: From 60 ft. to 140 ft., From ... ft. to ... ft.

GRAVEL PACK INTERVALS: From 15 ft. to 140 ft., From ... ft. to ... ft.

6 GROUT MATERIAL: 1 Neat cement 2 Cement grout 3 Bentonite 4 Other

Grout Intervals: From 0 ft. to 20 ft., From ... ft. to ... ft., From ... ft. to ... ft.

What is the nearest source of possible contamination:

1 Septic tank	4 Lateral lines	7 Pit privy	10 Livestock pens	14 Abandoned water well
2 Sewer lines	5 Cess pool	8 Sewage lagoon	11 Fuel storage	15 Oil well/Gas well
3 Watertight sewer lines	6 Seepage pit	9 Feedyard	12 Fertilizer storage	16 Other (specify below)
			13 Insecticide storage	

Direction from well? West

How many feet? 250

FROM	TO	LITHOLOGIC LOG	FROM	TO	LITHOLOGIC LOG
0	20	Overburden			
20	40	Coarse sand			
40	60	Coarse sand and clay			
60	80	Blue clay			
80	100	Coarse sand and clay			
100	120	Coarse sand and clay			
120	140	Coarse sand and clay			

7 CONTRACTOR'S OR LANDOWNER'S CERTIFICATION: This water well was (1) constructed, (2) reconstructed, or (3) plugged under my jurisdiction and was completed on (mo/day/year) 7-12-88 and this record is true to the best of my knowledge and belief. Kansas Water Well Contractor's License No. 142 This Water Well Record was completed on (mo/day/yr) 7-15-88 under the business name of T & W Water Well Service, INC. by (signature) T. Wagers

INSTRUCTIONS: Use typewriter or ball point pen. PLEASE PRESS FIRMLY and PRINT clearly. Please fill in blanks, underline or circle the correct answers. Send top three copies to Kansas Department of Health and Environment, Bureau of Water Protection, Topeka, Kansas 66620-7320, Telephone: 913-862-9360. Send one to WATER WELL OWNER and retain one for your records.

OFFICE USE ONLY  
T  
R  
EW  
SEC.  
1/4  
1/4  
1/4