


1 LOCATION OF WATER WELL:	Fraction	Section Number	Township Number	Range Number
County: Kearny	SW ¼ SW ¼ SE ¼	22	T 24 S	R 36W EW

Distance and direction from nearest town or city street address of well if located within city?
 900 Nabocaho

2 WATER WELL OWNER: Joyce Henderson
 RR#, St. Address, Box #: P.O. Box 1137
 City, State, ZIP Code: Lakin, KS 67860
 Board of Agriculture, Division of Water Resources
 Application Number:

3 LOCATE WELL'S LOCATION WITH AN "X" IN SECTION BOX:	4 DEPTH OF COMPLETED WELL: 150 ft. ELEVATION:
--	---

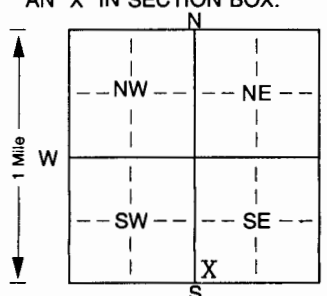

Depth(s) Groundwater Encountered 1. 110 ft. 2. ft. 3. ft.
 WELL'S STATIC WATER LEVEL: 30 ft. below land surface measured on mo/day/yr 4-25-01
 Pump test data: Well water was ft. after hours pumping gpm
 Est. Yield .15 gpm: Well water was ft. after hours pumping gpm
 Bore Hole Diameter: .9 in. to 1.50 ft., and in. to ft.
 WELL WATER TO BE USED AS: 5 Public water supply 8 Air conditioning 11 Injection well
 XX1 Domestic 3 Feedlot 6 Oil field water supply 9 Dewatering 12 Other (Specify below)
 2 Irrigation 4 Industrial 7 Domestic (lawn & garden) 10 Monitoring well
 Was a chemical/bacteriological sample submitted to Department? Yes. No. ; If yes, mo/day/yr sample was submitted
 Water Well Disinfected? Yes XX No

5 TYPE OF BLANK CASING USED: 5 Wrought iron 8 Concrete tile CASING JOINTS: Glued. XX. Clamped.
 1 Steel 3 RMP (SR) 6 Asbestos-Cement 9 Other (specify below) Welded
 XX 2 PVC 4 ABS 7 Fiberglass Threaded
 Blank casing diameter .5 in. to 1.30 ft., Dia. in. to ft., Dia. in. to ft.
 Casing height above land surface .18 in., weight 160 lbs./ft. Wall thickness or gauge No.
 TYPE OF SCREEN OR PERFORATION MATERIAL: XX PVC 10 Asbestos-cement
 1 Steel 3 Stainless steel 5 Fiberglass 8 RMP (SR) 11 Other (specify)
 2 Brass 4 Galvanized steel 6 Concrete tile 9 ABS 12 None used (open hole)
 SCREEN OR PERFORATION OPENINGS ARE: 5 Gauzed wrapped 8 Saw cut 11 None (open hole)
 1 Continuous slot XX Mill slot 6 Wire wrapped 9 Drilled holes
 2 Louvered shutter 4 Key punched 7 Torch cut 10 Other (specify) ft.
 SCREEN-PERFORATED INTERVALS: From .130 ft. to .150 ft., From ft. to ft.
 From ft. to ft., From ft. to ft.
 GRAVEL PACK INTERVALS: From .20 ft. to .100 ft., From .110 ft. to .150 ft.
 From ft. to ft., From ft. to ft.

6 GROUT MATERIAL: 1 Neat cement 2 Cement grout XX Bentonite 4 Other
 Grout Intervals: From 0 ft. to 20 ft., From 100 ft. to 110 ft., From ft. to ft.
 What is the nearest source of possible contamination: XX Livestock pens 14 Abandoned water well
 1 Septic tank 4 Lateral lines 7 Pit privy 11 Fuel storage 15 Oil well/Gas well
 2 Sewer lines 5 Cess pool 8 Sewage lagoon 12 Fertilizer storage 16 Other (specify below)
 3 Watertight sewer lines 6 Seepage pit 9 Feedyard 13 Insecticide storage
 Direction from well? North How many feet? 100

FROM	TO	LITHOLOGIC LOG	FROM	TO	PLUGGING INTERVALS
0	32	Brown Clay			
32	58	Gray Clay			
58	60	Black Clay			
60	65	Gray Clay			
65	98	Gray Clay & Sandstone Streaks			
98	110	Brown Clay			
110	120	Sand Fine			
120	140	Gray Clay			
140	159	Sand Medium			

7 CONTRACTOR'S OR LANDOWNER'S CERTIFICATION: This water well was (1) constructed, (2) reconstructed, or (3) plugged under my jurisdiction and was completed on (mo/day/year) 4-25-01 and this record is true to the best of my knowledge and belief. Kansas Water Well Contractor's Licence No. 677 This Water Well Record was completed on (mo/day/yr) 4-26-01 under the business name of CLT Water Well Service by (signature) CJ