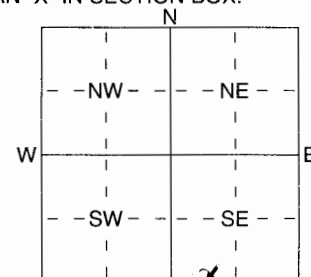


00327927

1 LOCATION OF WATER WELL: Fraction SW 1/4 SW 1/4 SE 1/4 Section Number 22 Township Number T 24 S Range Number R 36 E 10
 County: Kearny

Distance and direction from nearest town or city street address of well if located within city?

2 WATER WELL OWNER: Presta O, I
 RR#, St. Address, Box # : PO Box 1709 Garden City KS 67846
 City, State, ZIP Code : Garden City KS 67846
 Board of Agriculture, Division of Water Resources
 Application Number:

3 LOCATE WELL'S LOCATION WITH AN "X" IN SECTION BOX:

 4 DEPTH OF COMPLETED WELL 24.62 ft. ELEVATION: 3604.81
 Depth(s) Groundwater Encountered 1 19.92 ft. 2 ft. 3 ft.
 WELL'S STATIC WATER LEVEL 19.92 ft. below land surface measured on mo/day/yr 9/14/04
 Pump test data: Well water was ft. after NA hours pumping gpr
 Est. Yield 1.5 gpm: Well water was Bealed ft. after hours pumping gpr
 WELL WATER TO BE USED AS: 5 Public water supply 8 Air conditioning 11 Injection well
 1 Domestic 3 Feedlot 6 Oil field water supply 9 Dewatering 12 Other (Specify below)
 2 Irrigation 4 Industrial 7 Domestic (lawn & garden) 10 Monitoring well M.W.-10
 Was a chemical/bacteriological sample submitted to Department? Yes NO; If yes, mo/day/yr sample was submitted
 Water Well Disinfected? Yes NO

5 TYPE OF BLANK CASING USED:
 1 Steel 3 RMP (SR) 5 Wrought iron 8 Concrete tile CASING JOINTS: Glued Clamped
2 PVC 4 ABS 6 Asbestos-Cement 9 Other (specify below) Welded
 7 Fiberglass Threaded X
 Blank casing diameter 2.0 in. to 14.91 ft. Dia in. to ft. Dia in. to ft.
 Casing height above land surface 0.45 in., weight lbs./ft. Wall thickness or gauge No. Sch. 40
 TYPE OF SCREEN OR PERFORATION MATERIAL:
 1 Steel 3 Stainless Steel 5 Fiberglass PVC 10 Asbestos-Cement
 2 Brass 4 Galvanized Steel 6 Concrete tile 8 RMP (SR) 11 Other (Specify)
 12 None used (open hole)
 SCREEN OR PERFORATION OPENINGS ARE:
 1 Continuous slot 3 Mill slot 5 Gauzed wrapped 8 Saw cut 11 None (open hole)
 2 Louvered shutter 4 Key punched 6 Wire wrapped 9 Drilled holes
 7 Torch cut 10 Other (specify) ft.
 SCREEN-PERFORATED INTERVALS: From 24.62 ft. to 14.62 ft., From ft. to ft.
 From 14.62 ft. to 0.42 ft., From ft. to ft.
 GRAVEL PACK INTERVALS: From 13.1 ft. to 0.42 ft., From ft. to ft.
 From ft. to ft., From ft. to ft.

6 GROUT MATERIAL: 1 Neat cement 2 Cement grout Bentonite 4 Other
 Grout Intervals: From 13.1 ft. to 0.45 ft., From 0.45 ft. to 0.45 ft., From ft. to ft.
 What is the nearest source of possible contamination:
 1 Septic tank 4 Lateral lines 7 Pit privy 10 Livestock pens 14 Abandoned water well
2 Sewer lines 5 Cess pool 8 Sewage lagoon 11 Fuel storage 15 Oil well/Gas well
 3 Watertight sewer lines 6 Seepage pit 9 Feedyard 12 Fertilizer storage 16 Other (specify below)
 13 Insecticide storage
 Direction from well? How many feet? 100+

FROM	TO	LITHOLOGIC LOG	FROM	TO	PLUGGING INTERVALS
0	0.5	Topsoil w/ some gravel	0	0.45	Concrete Membrane casing
0.5	5	Silty clay			
5	7.5	Silty clay, trace plat, dmp sst 10R 7 1/2			
7.5	10	Some AS Above	13.1	0.45	3/8 Bentonite chip hydrated
10	12.5	Fr. sl. secm			
12.5	15.0	Silty clay - clayey st w/ some calcs, 10R 6 1/2			
15.0	20.0	Fr. sl. gradmats poorly sorted med			RECEIVED
20	25	Silt/clay w/ @ 20			OCT 25 2004
20	25	9+2 sids w/ gel net			BUREAU OF WATER

7 CONTRACTOR'S OR LANDOWNER'S CERTIFICATION: This water well was (1) constructed, (2) reconstructed, or (3) plugged under my jurisdiction and was completed on (mo/day/year) 9/14/04 and this record is true to the best of my knowledge and belief. Kansas Water Well Contractor's Licence No. 554 This Water Well Record was completed on (mo/day/yr) 10/15/04 under the business name of Woolfe Pump & Well by (signature) Jim Potts for Ken Woolfe