WATER WELL RECORD Form WWC-5 KSA 82a-1212 ID No. 00327910

1 LOCATION OF WATER WELL: County: Kearny	Fraction SW ¼ SW ¼ SW ¼ SE	Section Number 22	Township Number T 24 S	Range Number R 36 E/W

Distance and direction from nearest town or city street address of well if located within city?
516 N. Main Well is ≈ 120' S

2 WATER WELL OWNER: Presta Oil Co.
RR#, St. Address, Box # : P.O. Box 1709 Garden City Ks 67846
City, State, ZIP Code :
Board of Agriculture, Division of Water Resources Application Number:

3 LOCATE WELL'S LOCATION WITH AN "X" IN SECTION BOX:

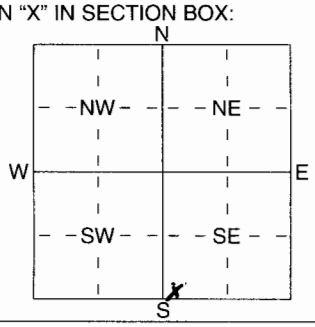

4 DEPTH OF COMPLETED WELL 24.82 ft. ELEVATION: 3005.75
Depth(s) Groundwater Encountered 1 17.5' BGS ft. 2 ft. 3 ft.
WELL'S STATIC WATER LEVEL 17.5 ft. below land surface measured on mo/day/yr 9/14/04
Pump test data: Well water was NA ft. after hours pumping gpm
Est. Yield 1.5 gpm: Well water was Bailed ft. after hours pumping gpm
WELL WATER TO BE USED AS: 1 Domestic 2 Irrigation 3 Feedlot 4 Industrial 5 Public water supply 6 Oil field water supply 7 Domestic (lawn & garden) 8 Air conditioning 9 Dewatering 10 Monitoring well MW-09 11 Injection well 12 Other (Specify below)

Was a chemical/bacteriological sample submitted to Department? Yes No ; If yes, mo/day/yrs sample was submitted
Water Well Disinfected? Yes No

5 TYPE OF BLANK CASING USED: 1 Steel 2 PVC 3 RMP (SR) 4 ABS 5 Wrought iron 6 Asbestos-Cement 7 Fiberglass 8 Concrete tile 9 Other (specify below)
CASING JOINTS: Glued Clamped Welded Threaded X
Blank casing diameter 2.0 in. to 14.82 ft., Dia — in. to — ft., Dia — in. to — ft.
Casing height ~~above~~ land surface 0.42 BGS in., weight lbs./ft. Wall thickness or guage No. Sch 40
TYPE OF SCREEN OR PERFORATION MATERIAL: 1 Steel 2 Brass 3 Stainless Steel 4 Galvanized Steel 5 Fiberglass 6 Concrete tile 7 PVC 8 RMP (SR) 9 ABS 10 Asbestos-Cement 11 Other (Specify) 12 None used (open hole)
SCREEN OR PERFORATION OPENINGS ARE: 1 Continuous slot 2 Louvered shutter 3 Mill slot 4 Key punched 5 Guazed wrapped 6 Wire wrapped 7 Torch cut 8 Saw cut 9 Drilled holes 10 Other (specify) 11 None (open hole)
SCREEN-PERFORATED INTERVALS: From 24.82 ft. to 14.82 ft., From ft. to ft.
From ft. to ft., From ft. to ft.
GRAVEL PACK INTERVALS: From 24.82 ft. to 13.1 ft., From ft. to ft.
From ft. to ft., From ft. to ft.

6 GROUT MATERIAL: 1 Neat cement 2 Cement grout 3 Bentonite 4 Other
Grout Intervals: From 13.1 ft. to 0.45 ft., From 0.45 ft. to 0.0 Concrete ft., From ft. to ft.
What is the nearest source of possible contamination: 1 Septic tank 2 Sewer lines 3 Watertight sewer lines 4 Lateral lines 5 Cess pool 6 Seepage pit 7 Pit privy 8 Sewage lagoon 9 Feedyard 10 Livestock pens 11 Fuel storage 12 Fertilizer storage 13 Insecticide storage 14 Abandoned water well 15 Oil well/Gas well 16 Other (specify below)
Direction from well? How many feet? 100+

FROM	TO	LITHOLOGIC LOG	FROM	TO	PLUGGING INTERVALS
0	2	Topsoil Dry	0	0.42	Concrete
2	5	Silty cly - Clayey slt 10YR 5/6		0.42	
5	10	Same As Above 10YR 4/3			3/8 Chip Bentonite
10	12.5	slts grading to Fn sd non plst dry	13.1		
12.5	15	Fn sd - clyey slts			
15	17.5	Cly, med plst, dnp (10 YR 4/2)			
17.5	18.5	Fn - med sd w some gvl (10YR 5/4)			
18.5	20	Med sd, course gvl poorly sorted			
		loose moist @ 20.5 (10 YR 6/8)			
20	25	Same As Above but wet			

RECEIVED
OCT 25 2004
BUREAU OF WATER

7 CONTRACTOR'S OR LANDOWNER'S CERTIFICATION: This water well was (1) constructed, (2) reconstructed, or (3) plugged under my jurisdiction and was completed on (mo/day/year) 9/14/04 and this record is true to the best of my knowledge and belief. Kansas Water Well Contractor's Licence No 554 This Water Well Record was completed on (mo/day/yr) 10/15/04 under the business name of Wolfe Pump + Well by (signature) Jim Roberts for Jay Wolfe

INSTRUCTIONS: Use typewriter or ball point pen. PLEASE PRESS FIRMLY and PRINT clearly. Please fill in blanks, underline or circle the correct answers. Send top three copies to Kansas Department of Health and Environment, Bureau of Water, Geology Section, 1000 SW Jackson St., Suite 420, Topeka, Kansas 66612-1367. Telephone 785-296-5522. Send one to WATER WELL OWNER and retain one for your records. Fee of $5.00 for each constructed well.