


WATER WELL RECORD Form WWC-5 KSA 82a-1212

1 LOCATION OF WATER WELL: Fraction Section Number Township Number Range Number  
 COUNTY: 047 KBARNY NW 1/4 NE 1/4 SE 1/4 32 T 24 S R 36 W

Distance and direction from nearest town or city street address of well if located within city?  
 FROM LAKIN; APPX 3/4 MILE SOUTH & 1 1/4 MILES WEST

2 WATER WELL OWNER: MRS. OTIS JENNINGS  
 RR#, St. Address, Box #: HC 3 BOX 2 Board of Agriculture, Division of Water Resources  
 City, State, ZIP code: LAKIN, KS 67860-9401 Application Number:

3 LOCATE WELL'S LOCATION WITH AN "X" IN SECTION BOX:

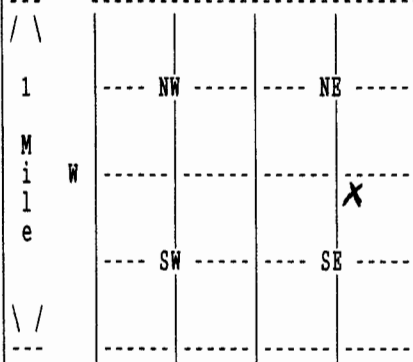

4 DEPTH OF COMPLETED WELL 75 ELEVATION: 0  
 Depth(s) Groundwater Encountered 1. 0 ft. 2. 0 ft. 3. 0 ft.

WELL'S STATIC WATER LEVEL 2.0 ft. below land surface measured on mo/day/yr 12/15/05  
 Pump test data: Well water was 0 ft. after 0 hours pumping 0 gpm  
 Estimated Yield 0 gpm: Well water was 0 ft. after 0 hours pumping 0 gpm  
 Bore Hole Diameter 10 in. to 75 ft., and in. to 0 ft.  
 WELL WATER TO BE USED AS: 01 DOMESTIC

Was a chemical/bacteriological sample submitted to department? No ;  
 If yes, mo/day/yr sample was submitted Water well disinfected? Yes

5 TYPE OF BLANK CASING USED: 02 PVC CASING JOINTS: OTHER CASING JNT - Cert. Yok  
 Blank casing diameter 5 in. to 75 ft., Dia in. to 0 ft., Dia in. to 0 ft.  
 Casing height above land surface 12 in., weight 3 lbs/ft. Wall thickness or gauge No. .265  
 TYPE OF SCREEN OR PERFORATION MATERIAL: 07 PVC  
 SCREEN OR PERFORATION OPENINGS ARE: 03 MILL SLOT

SCREEN PERFORATED INTERVALS: From 55 ft. to 75 ft., From 0 ft. to 0 ft.  
 From 0 ft. to 0 ft., From 0 ft. to 0 ft.  
 GRAVEL PACK INTERVALS: From 25 ft. to 75 ft., From 0 ft. to 0 ft.  
 From 0 ft. to 0 ft., From 0 ft. to 0 ft.

6 GROUT MATERIAL 03 BRNTONITE  
 Grout Intervals: From 5 ft. to 25 ft., From 0 ft. to 0 ft., From 0 ft. to 0 ft.  
 What is the nearest source of possible contamination: NONE OBSERVED  
 Direction from well? How many feet? 0

FROM	TO	LITHOLOGIC LOG	FROM	TO	PLUGGING INTERVALS
0	2	02 SILT			
2	25	04 SANDY CLAY			
25	43	05 SAND 13 FINE GRAVEL 14 MED GRAVEL			
43	46	04 SANDY CLAY			
46	69	05 SAND 01 CLAY			
69	74	07 FINE SAND 08 MEDIUM SAND			
74	75	19 SHALE			

7 CONTRACTOR'S OR LANDOWNER'S CERTIFICATION: This water well was Constructed under my jurisdiction and was completed on (mo/day/year) 11/30/05 and this record is true to the best of my knowledge and belief. Kansas Water Well Contractor's License No. 145 This Water Well Record was completed on (mo/day/yr) 01/12/06 under the business name of HENKLE DRILLING & SUPPLY by (signature) *Bruce J. Kurbanick*