


WATER WELL RECORD Form WWC-5 KSA 82a-1212

1 LOCATION OF WATER WELL: Fraction Section Number Township Number Range Number  
 COUNTY: 047 KEARNY NE 1/4 NE 1/4 SE 1/4 15 T 24 S R 36 W

Distance and direction from nearest town or city street address of well if located within city?  
 FROM LAKIN; APPX 1 MILE NORTH

2 WATER WELL OWNER: HAROLD WHITE  
 RR#, St. Address, Box # : GCR 3 BOX 6 Board of Agriculture, Division of Water Resources  
 City, State, ZIP code : LAKIN, KS Application Number:

3 LOCATE WELL'S LOCATION WITH AN "X" IN SECTION BOX:

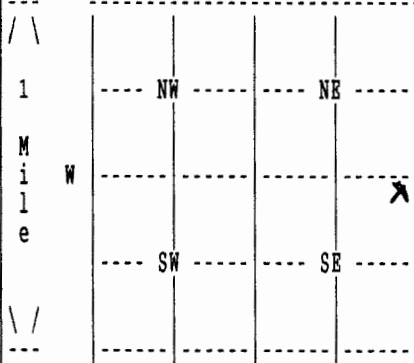

4 DEPTH OF COMPLETED WELL 160 ELEVATION: 0  
 Depth(s) Groundwater Encountered 1. 0 ft. 2. 0 ft. 3. 0 ft.

WELL'S STATIC WATER LEVEL 50 ft. below land surface measured on mo/day/yr 1/14/06  
 Pump test data: Well water was 0 ft. after 0 hours pumping 0 gpm

Estimated Yield 0 gpm: Well water was 0 ft. after 0 hours pumping 0 gpm

Bore Hole Diameter 10 in. to 160 ft., and in. to 0 ft.

WELL WATER TO BE USED AS: 01 DOMESTIC

Was a chemical/bacteriological sample submitted to department? No ;  
 If yes, mo/day/yr sample was submitted Water well disinfected? Yes

5 TYPE OF BLANK CASING USED: 02 PVC CASING JOINTS: GLUED  
 Blank casing diameter 5 in. to 160 ft., Dia in. to 0 ft., Dia in. to 0 ft.  
 Casing height above land surface 12 in., weight 3 lbs/ft. Wall thickness or gauge No. .265  
 TYPE OF SCREEN OR PERFORATION MATERIAL: 07 PVC  
 SCREEN OR PERFORATION OPENINGS ARE: 03 MILL SLOT

SCREEN PERFORATED INTERVALS: From 100 ft. to 160 ft., From 0 ft. to 0 ft.  
 From 0 ft. to 0 ft., From 0 ft. to 0 ft.  
 GRAVEL PACK INTERVALS: From 25 ft. to 160 ft., From 0 ft. to 0 ft.  
 From 0 ft. to 0 ft., From 0 ft. to 0 ft.

6 GROUT MATERIAL 03 BENTONITE  
 Grout Intervals: From 5 ft. to 25 ft., From 0 ft. to 0 ft., From 0 ft. to 0 ft.  
 What is the nearest source of possible contamination: 14 ABAND. WELL  
 Direction from well? NORTHWEST How many feet? 15

FROM	TO	LITHOLOGIC LOG	FROM	TO	PLUGGING INTERVALS
0	2	02 SILT			
2	23	04 SANDY CLAY			
23	34	05 SAND 13 FINE GRAVEL			
34	46	04 SANDY CLAY			
46	50	05 SAND 13 FINE GRAVEL			
50	67	04 SANDY CLAY 05 SAND			
67	78	05 SAND			
78	90	04 SANDY CLAY			
90	149	05 SAND 13 FINE GRAVEL			
149	154	04 SANDY CLAY			

7 CONTRACTOR'S OR LANDOWNER'S CERTIFICATION: This water well was Constructed under my jurisdiction and was completed on (mo/day/year) 01/14/06 and this record is true to the best of my knowledge and belief. Kansas  
 Water Well Contractor's License No. 145 This Water Well Record was completed on (mo/day/yr) 04/19/06  
 under the business name of HENKLE DRILLING & SUPPLY by (signature)

*Harold White*

(Continued)

WATER WELL RECORD Form WWC-5 KSA 82a-1212

1 LOCATION OF WATER WELL: COUNTY: 047 KEARNY	Fraction NE 1/4 NE 1/4 SE 1/4	Section Number 15	Township Number T 24 S	Range Number R 36 W
---	----------------------------------	----------------------	---------------------------	------------------------

2 WATER WELL OWNER: HAROLD WHITE  
RR#, St. Address, Box # : GCR 3 BOX 6  
City, State, ZIP code : LAKIN, KS -

Board of Agriculture, Division of Water Resources  
Application Number: |

FROM	TO	LITHOLOGIC LOG
154	160	05 SAND

7 CONTRACTOR'S OR LANDOWNER'S CERTIFICATION: This water well was Constructed under my jurisdiction and was completed on (mo/day/year) 01/14/06 and this record is true to the best of my knowledge and belief. Kansas Water Well Contractor's License No. 145 This Water Well Record was completed on (mo/day/yr) 04/19/06 under the business name of HENKLE DRILLING & SUPPLY by (signature) *Bruce J. Henkle*