

USE TYPEWRITER OR BALL POINT PEN—PRESS FIRMLY, PRINT CLEARLY.

T R EW sec 1/4 1/4 1/4 No.


WATER WELL RECORD
KSA 82a-1201-1215

Kansas State Dept. Of Health
(Water Well Contractors)
Forbes-Bldg. 740
Topeka, Kansas 66620

1 Location of well: County Leary Township name _____ Fraction NE 1/4 Section number 25 Town number 24 Range number 36

Distance and direction from nearest town or city: South
Street address of well location if in city: _____

3 Owner of well: Goe Baird
Address: Lakin, Kansas

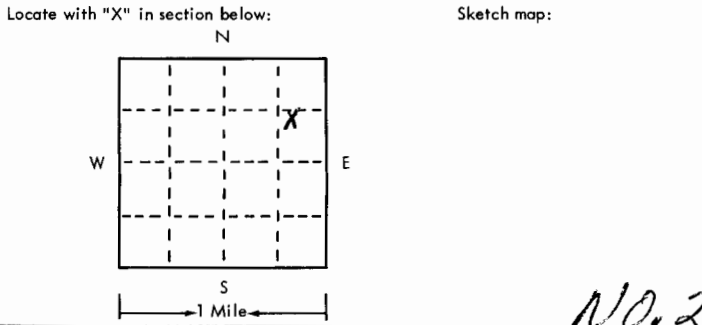

4 Well depth: 50 ft. Date of completion 2/25/75
Well diameter 5 in.
5 Cable tool Rotary Driven Dug
 Hollow rod Jetted Bored Reverse rotary
6 Use: Domestic Public supply Industry
 Irrigation Air conditioning Commercial
 Test well _____
7 Casing: Material PVC Height: above/below
Threaded Welded Surface 12 in.
Diam. 5 in. Weight 125 lbs./ft.
5 in. to 50 ft. depth Drive shoe? Yes No
_____ in. to _____ ft. depth

2

Type and color of material	From	To
<u>Fine Sand</u>	<u>0</u>	<u>15</u>
<u>Coarse gravel (loose)</u>	<u>15</u>	<u>31</u>
<u>mixed with Rock</u>		
<u>Grey Clay</u>	<u>31</u>	<u>33</u>
<u>Fine to med sand & gravel</u>	<u>33</u>	<u>50</u>
<u>(loose) small streaks clay</u>		

(use a second sheet if needed)

8 Screen: Manufacturer Pumped Special
Type PVC Dia. 5"
Slot/gauze 1/8" Length 30'
Set between 20 ft. and 50 ft. _____
Fittings: Gravel pack Yes No Size range of material 1/4"
9 Static water level: 16 ft. below land surface Date 2/25/75
10 Pumping level below land surfaces:
16 ft. after _____ hrs. pumping _____ g.p.m.
_____ ft. after _____ hrs. pumping _____ g.p.m.
Estimated maximum yield _____ g.p.m.
11 Water sample submitted:
 Yes No Date _____
12 Well head completion:
 Pitless adapter 24 inches above grade
13 Well grouted? Yes No
 Neat cement Bentonite _____
Depth: From _____ ft. to _____ ft.
14 Nearest source of possible contamination:
ft. 200 Direction South Type Stock Corral
Well disinfected upon completion? Yes No
15 Pump: Not installed
Manufacturer's name _____
Model number _____ HP _____ Volts _____
Length of drop pipe _____ ft. capacity _____ g.p.m.
Type:
 Submersible Turbine
 Jet Reciprocating
 Centrifugal Other

16 Remarks: elevation
Topography:
 Hill
 Slope
 Upland
 Valley
Again Customer needed to dig for well pit & will grub himself

17 Water well contractor's certification:
This well was drilled under my jurisdiction and this report is true to the best of my knowledge and belief.
Jonagan Drilling Inc
Business name _____ license No. _____
Address Box 561 Hardisty
Signed Martha Jang Date 5/12/75
Authorized representative