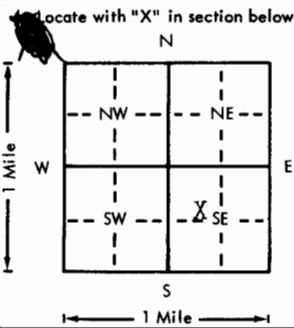


USE TYPEWRITER OR BALL POINT PEN-PRESS FIRMLY, PRINT CLEARLY.

WATER WELL RECORD
KSA 82a-1201-1215

Kansas Department of Health and Environment-Division of Environment
(Water well Contractors)
Topeka, Kansas 66620

1. Location of well:	County: <u>Kearny</u>	Fraction: <u>SE 1/4 NW 1/4 SE 1/4</u>	Section number: <u>15</u>	Township number: <u>T 24 S</u>	Range number: <u>R 36 E/W</u>		
2. Distance and direction from nearest town or city: <u>1 1/2 Miles North</u> Street address of well location if in city: <u>of Lakin, Ks.</u>			3. Owner of well: <u>Lakin Sportsman's Club</u> R.R. or street: City, state, zip code: <u>Lakin, Kans. 67860</u>				
4. Locate with "X" in section below: 		Sketch map:		6. Bore hole dia. <u>18</u> in. Completion date _____ Well depth <u>197</u> ft. <u>8-12-80</u>			
5. Type and color of material		From	To	7. <input type="checkbox"/> Cable tool <input type="checkbox"/> Rotary <input type="checkbox"/> Driven <input type="checkbox"/> Dug <input type="checkbox"/> Hollow rod <input type="checkbox"/> Jetted <input type="checkbox"/> Bored <input checked="" type="checkbox"/> Reverse rotary			
		Top soil & clay		0	20	8. Use: <input type="checkbox"/> Domestic <input type="checkbox"/> Public supply <input type="checkbox"/> Industry <input type="checkbox"/> Irrigation <input type="checkbox"/> Air conditioning <input type="checkbox"/> Stock <input type="checkbox"/> Lawn <input type="checkbox"/> Oil field water <input checked="" type="checkbox"/> Other	
		Clay & little cemented sand		20	30	9. Casing: Material <u>steel</u> Height: Above or below Threaded _____ Welded <input checked="" type="checkbox"/> Surface <u>12</u> in. RMP _____ PVC _____ Weight _____ lbs./ft. Dia. <u>8 5/8</u> in. to <u>157</u> ft. depth Wall Thickness: inches or Dia. _____ in. to _____ ft. depth gage No. <u>219</u>	
		Sand & little clay		30	105	10. Screen: Manufacturer's name _____ Type <u>Steel</u> Dia. <u>8 5/8</u> Slot/size _____ Length <u>40</u> Set between <u>157</u> ft. and <u>197</u> ft. _____ ft. and _____ ft. Gravel pack? <input checked="" type="checkbox"/> yes Size range of material <u>1/4 - 5/8"</u>	
		Clay		105	126	11. Static water level: _____ mo./day/yr. <u>50</u> ft. below land surface Date <u>8-10-80</u>	
		Sand & little clay		126	189	12. Pumping level below land surfaces: <u>100</u> ft. after <u>3</u> hrs. pumping <u>90</u> g.p.m. _____ ft. after _____ hrs. pumping _____ g.p.m. Estimated maximum yield <u>90</u> g.p.m.	
		Clay		189	197	13. Water sample submitted: _____ mo./day/yr. Yes <input type="checkbox"/> No <input checked="" type="checkbox"/> Date _____	
						14. Well head completion: <input type="checkbox"/> Pitless adapter <u>12</u> Inches above grade	
						15. Well grouted? _____ With: <input checked="" type="checkbox"/> Neat cement _____ Bentonite _____ Concrete _____ Depth: From <u>0</u> ft. to <u>10</u> ft.	
						16. Nearest source of possible contamination: ft. _____ Direction _____ Type <u>None</u> Well disinfected upon completion? <input checked="" type="checkbox"/> Yes _____ No _____	
				17. Pump: _____ Not installed Manufacturer's name <u>Jacuzzi</u> Model number <u>256B5-1/AHP</u> <u>5</u> Volts <u>440</u> Length of drop pipe <u>168</u> ft. capacity <u>80</u> g.p.m. Type: <input checked="" type="checkbox"/> Submersible _____ Turbine <input type="checkbox"/> Jet _____ Reciprocating <input type="checkbox"/> Centrifugal _____ Other _____			
18. Elevation:	19. Remarks: <u>This well is near a lake</u>		20. Water well contractor's certification: This well was drilled under my jurisdiction and this report is true to the best of my knowledge and belief. <u>Ark Valley Pump & Supply 123A</u> Business name _____ License No. _____ Address <u>Box 235 Holl. Co.</u> <u>81047</u> Signed <u>[Signature]</u> Date <u>11-9-80</u> Authorized representative				

24
 36
 15
 1/4 SE NW SE
 Sec 15
 1/4 1/4 SE

Forward the white, blue and pink copies to the Department of Health and Environment

Form WWC-5