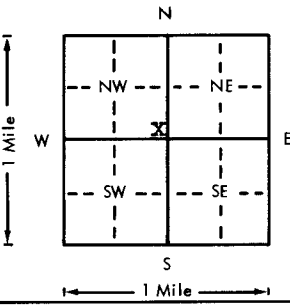
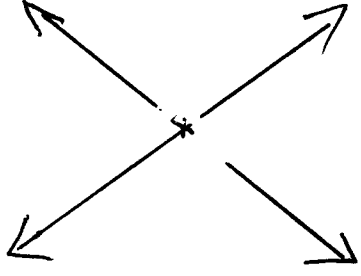


USE TYPEWRITER OR BALL POINT PEN-PRESS FIRMLY, PRINT CLEARLY.

WATER WELL RECORD
KSA 82a-1201-1215

Kansas Department of Health and Environment-Division of Environment
(Water well Contractors)
Topeka, Kansas 66620

1. Location of well:	County Kearny	Fraction SE 1/4 SE 1/4 NW 1/4	Section number 22	Township number T 24 S R 36	Range number X/W
2. Distance and direction from nearest town or city: Outside N edge of Lakin, Ks. Street address of well location if in city:			3. Owner of well: E. J. Randolph R.R. or street: Lakin City, state, zip code: Ks. 67860		
4. Locate with "X" in section below: 			Sketch map: 		
5. Type and color of material			From	To	6. Bore hole dia. 1 1/2 in. Completion date 10-1-80 Well depth 240 ft.
Clay			0	40	7. <input checked="" type="checkbox"/> Cable tool <input checked="" type="checkbox"/> Rotary <input type="checkbox"/> Driven <input type="checkbox"/> Dug <input type="checkbox"/> Hollow rod <input type="checkbox"/> Jetted <input type="checkbox"/> Bored <input type="checkbox"/> Reverse rotary
Dirty blue clay			40	80	8. Use: <input checked="" type="checkbox"/> Domestic <input type="checkbox"/> Public supply <input type="checkbox"/> Industry <input type="checkbox"/> Irrigation <input type="checkbox"/> Air conditioning <input type="checkbox"/> Stock <input type="checkbox"/> Lawn <input type="checkbox"/> Oil field water <input type="checkbox"/> Other
Sand			80	100	9. Casing: Material <input type="checkbox"/> Height <input checked="" type="checkbox"/> Above or below Threaded <input type="checkbox"/> Welded 8 1/2 Surface 6 in. RMP <input type="checkbox"/> PVC <input checked="" type="checkbox"/> Weight 200 lbs./ft. Dia. 8 in. to 240 ft. depth Wall Thickness: inches or Dia. <input type="checkbox"/> in. to <input type="checkbox"/> ft. depth gage No. 410
Sand, clay balls			100	120	10. Screen: Manufacturer's name Peerless Plastic Type PVC Dia. 8 in. <input checked="" type="checkbox"/> Slot gauze 0.061x3 in. Length 60 ft. Set between 180 ft. and 240 ft. ft. and <input type="checkbox"/> ft. Gravel pack? <input checked="" type="checkbox"/> Yes Size range of material 1/4
Sand, clay streaks			120	180	11. Static water level: <input type="checkbox"/> mo./day/yr. 52 ft. below land surface Date 9-1-80
Coarse, clean sand			180	240	12. Pumping level below land surfaces: 60 ft. after 2 hrs. pumping 100 g.p.m. <input type="checkbox"/> ft. after <input type="checkbox"/> hrs. pumping <input type="checkbox"/> g.p.m. Estimated maximum yield 100 g.p.m.
Clay or shale, lost circulation			240		13. Water sample submitted: <input type="checkbox"/> Yes <input checked="" type="checkbox"/> No Date <input type="checkbox"/>
					14. Well head completion: <input type="checkbox"/> Pitless adapter 6 inches above grade
					15. Well grouted? <input checked="" type="checkbox"/> Yes With <input checked="" type="checkbox"/> Neat cement <input type="checkbox"/> Bentonite <input type="checkbox"/> Concrete Depth: From 0 ft. to 10 ft.
					16. Nearest source of possible contamination: NA ft. <input type="checkbox"/> Direction <input type="checkbox"/> Type <input type="checkbox"/> Well disinfected upon completion? <input checked="" type="checkbox"/> Yes <input type="checkbox"/> No
					17. Pump: <input type="checkbox"/> Not installed Manufacturer's name Goulds Model number JHM66KM12 HP 7 1/2 Volts 230 Length of drop pipe 189 ft. capacity 100 g.p.m. Type: <input checked="" type="checkbox"/> Submersible <input type="checkbox"/> Turbine <input type="checkbox"/> Jet <input type="checkbox"/> Reciprocating <input type="checkbox"/> Centrifugal <input type="checkbox"/> Other
					(Use a second sheet if needed)
18. Elevation:	19. Remarks:		20. Water well contractor's certification: This well was drilled under my jurisdiction and this report is true to the best of my knowledge and belief.		
Topography: <input checked="" type="checkbox"/> Hill <input type="checkbox"/> Slope <input type="checkbox"/> Upland <input type="checkbox"/> Valley			High Plains Drilling & Supply, Inc. 136B Business name 5310 W. Hwy 50-R#1, Garden City, Ks. 67846 License No. 14 Address 5310 W. Hwy 50-R#1, Garden City, Ks. 67846 Signed Arthur T. K... Date 10-1-80 Authorized representative		

T 24 S R 36 E
1/4 1/4 1/4

Forward the white, blue and pink copies to the Department of Health and Environment

Form WWC-5