




Corrected, per well owner, 10/14/2014

DRL BR

1 LOCATION OF WATER WELL: County: Kearny Fraction NE 1/4 NE 1/4 NW 1/4 NE 1/4 Section Number 21 Township Number T 24 S Range Number R 36 E W

2 WELL OWNER: Last Name: Berlier First: Wade Street or Rural Address where well is located (if unknown, distance and direction from nearest town or intersection): If at owner's address, check here: [X] Business: Address: box-1044 P.O. Box 1044 City: Lakin State: Ks. ZIP: 67860

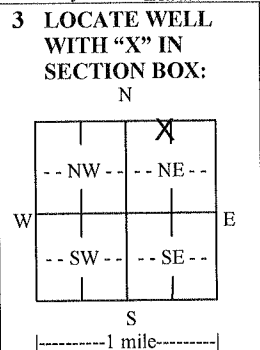

3 LOCATE WELL WITH 'X' IN SECTION BOX: N W E S 1 mile 4 DEPTH OF COMPLETED WELL: 555 ft. Depth(s) Groundwater Encountered: 1) 96 ft. 2) ... ft. 3) ... ft., or 4) [] Dry Well WELL'S STATIC WATER LEVEL: 96 ft. [X] below land surface, measured on (mo-day-yr) 02/03/2014 [] above land surface, measured on (mo-day-yr) ... Pump test data: Well water was ... after ... hours pumping ... gpm Well water was ... after ... hours pumping ... gpm Estimated Yield: 30 gpm Bore Hole Diameter: 12 in. to 555 ft. and ... in. to ... ft.

5 Latitude: 37.95815 (decimal degrees) Longitude: 101.27253 (decimal degrees) Datum: [X] WGS 84 [] NAD 83 [] NAD 27 Source for Latitude/Longitude: [] GPS (unit make/model: ... (WAAS enabled? [] Yes [] No) [] Land Survey [] Topographic Map [] Online Mapper: ...

6 Elevation: 3071 ft. [X] Ground Level [] TOC Source: [] Land Survey [] GPS [] Topographic Map [X] Other KOLAR

7 WELL WATER TO BE USED AS: 1. Domestic: [X] Household [X] Lawn & Garden [X] Livestock 2. [] Irrigation 3. [] Feedlot 4. [] Industrial 5. [] Public Water Supply: well ID ... 6. [] Dewatering: how many wells? ... 7. [] Aquifer Recharge: well ID ... 8. [] Monitoring: well ID ... 9. Environmental Remediation: well ID ... [] Air Sparge [] Soil Vapor Extraction [] Recovery [] Injection 10. [] Oil Field Water Supply: lease ... 11. Test Hole: well ID ... [] Cased [] Uncased [] Geotechnical 12. Geothermal: how many bores? ... a) Closed Loop [] Horizontal [] Vertical b) Open Loop [] Surface Discharge [] Inj. of Water 13. [] Other (specify): ...

Was a chemical/bacteriological sample submitted to KDHE? [] Yes [X] No If yes, date sample was submitted: ... Water well disinfected? [X] Yes [] No

8 TYPE OF CASING USED: [] Steel [X] PVC [] Other ... CASING JOINTS: [] Glued [X] Clamped [] Welded [] Threaded Casing diameter 6 in. to 555 ft., Diameter ... in. to ... ft., Diameter ... in. to ... ft. Casing height above land surface 18 in. Weight ... lbs./ft. Wall thickness or gauge No. SDR17 & 21

TYPE OF SCREEN OR PERFORATION MATERIAL: [] Steel [] Stainless Steel [] Fiberglass [X] PVC [] Other (Specify) ... [] Brass [] Galvanized Steel [] Concrete tile [] None used (open hole)

SCREEN OR PERFORATION OPENINGS ARE: [] Continuous Slot [X] Mill Slot [] Gauze Wrapped [] Torch Cut [] Drilled Holes [] Other (Specify) ... [] Louvered Shutter [] Key Punched [] Wire Wrapped [] Saw Cut [] None (Open Hole)

SCREEN-PERFORATED INTERVALS: From 255 ft. to 335 ft., From 475 ft. to 495 ft., From 515 ft. to 535 ft. GRAVEL PACK INTERVALS: From 24 ft. to 240 ft., From 260 ft. to 400 ft., From 455 ft. to 535 ft.

9 GROUT MATERIAL: [] Neat cement [] Cement grout [X] Bentonite [] Other ... Grout Intervals: From 4 ft. to 24 ft., From 240 ft. to 260 ft., From 400 ft. to 455 ft.

Nearest source of possible contamination: [] Septic Tank [] Lateral Lines [] Pit Privy [] Livestock Pens [] Insecticide Storage [] Sewer Lines [] Cess Pool [] Sewage Lagoon [] Fuel Storage [] Abandoned Water Well [] Watertight Sewer Lines [] Seepage Pit [] Feedyard [] Fertilizer Storage [] Oil Well/Gas Well [] Other (Specify) ... Direction from well? ... Distance from well? ... ft.

Table with 5 columns: FROM, TO, LITHOLOGIC LOG, FROM, TO, LITHO. LOG (cont.) or PLUGGING INTERVALS. Rows include lithological descriptions like 'top soil/ clay/ fine sand', 'streaks shale & sandstone', 'shale/sand/streaks shale& sandstone', 'shale/ streak sand', 'streaks clay & sand', 'sandy clay/streak sandstone', 'shale/limestone/sandstone', 'shale/ limestone', 'shale/streak sand/ limestone', 'sand/streak finesand'.

11 CONTRACTOR'S OR LANDOWNER'S CERTIFICATION: This water well was [X] constructed, [] reconstructed, or [] plugged under my jurisdiction and was completed on (mo-day-year) 04/19/2014 and this record is true to the best of my knowledge and belief. Kansas Water Well Contractor's License No. 775 This Water Well Record was completed on (mo-day-year) 04/19/2014 under the business name of Martin's Well Service