


1 LOCATION OF WATER WELL:
County: Kearny
Fraction: SW 1/4 SE 1/4 SW 1/4
Section Number: 22
Township Number: T 24 S
Range Number: R 36 W

Distance and direction from nearest town or city street address of well if located within city?
306 Hwy 50, Lakin, KS

2 WATER WELL OWNER: Margaret Spellman
RR#, St. Address, Box #: 4821 Mexico Gravel Rd.
City, State, ZIP Code: Columbia, MO 65202
Board of Agriculture, Division of Water Resources
Application Number:

3 LOCATE WELL'S LOCATION WITH AN 'X' IN SECTION BOX:
4 DEPTH OF COMPLETED WELL: 35 ft. ELEVATION: 3011.98
Depth(s) Groundwater Encountered: 1.5 ft. 28.5 ft. 3 ft.
WELL'S STATIC WATER LEVEL: Dry ft. below land surface measured on mo/day/yr 07/17/14
Pump test data: Well water was Ft. after hours pumping Gpm
Est. Yield Gpm: Well water was Ft. after Hours pumping Gpm
Bore Hole Diameter: 8.5 in. to 35 ft. and in. to Ft.
WELL WATER TO BE USED AS: 5 Public water supply 8 Air conditioning 11 Injection well
1 Domestic 3 Feed lot 6 Oil field water supply 9 Dewatering 12 Other (Specify below)
2 Irrigation 4 Industrial 7 Lawn and garden (domestic) 10 Monitoring well MW-13
Was a chemical/bacteriological sample submitted to Department? Yes No X If yes, mo/day/yr sample was Submitted
Water Well Disinfected? Yes No X

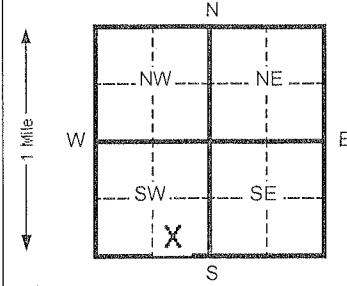

5 TYPE OF BLANK CASING USED:
1 Steel 3 RMP (SR) 5 Wrought Iron 8 Concrete tile CASING JOINTS: Glued Clamped
2 PVC 4 ABS 6 Asbestos-Cement 9 Other (specify below) Welded
7 Fiberglass Threaded X
Blank casing diameter 2 in. to 25 Ft., Dia in. to ft., Dia in. to ft.
Casing height above land surface FLUSH In., weight SCH 40 Lbs./ft. Wall thickness or gauge No.
TYPE OF SCREEN OR PERFORATION MATERIAL: 7 PVC 10 Asbestos-cement
1 Steel 3 Stainless steel 5 Fiberglass 8 RMP (SR) 11 Other (specify)
2 Brass 4 Galvanized steel 6 Concrete tile 9 ABS 12 None used (open hole)
SCREEN OR PERFORATION OPENINGS ARE: 5 Gauzed wrapped 8 Saw cut 11 None (open hole)
1 Continuous slot 3 Mill slot 6 Wire wrapped 9 Drilled holes
2 Louvered shutter 4 Key punched 7 Torch cut 10 Other (specify)
SCREEN-PERFORATED INTERVALS: From 25 ft. to 35 ft. From ft. to ft.
SAND PACK INTERVALS: From 23 ft. to 35 ft. From ft. to ft.

6 GROUT MATERIAL: 1 Neat cement 2 Cement grout 3 Bentonite 4 Other
Grout Intervals From 2 0.5 ft. to 21 Ft. From 3 21 to 23 ft. From ft. to ft.
What is the nearest source of possible contamination:
1 Septic tank 4 Lateral lines 7 Pit privy 10 Livestock pens 14 Abandoned water well
2 Sewer lines 5 Cess pool 8 Sewage lagoon 11 Fuel storage 15 Oil well/ Gas well
3 Watertight sewer lines 6 Seepage pit 9 Feedyard 12 Fertilizer storage 16 Other (specify below) Contaminated Site
13 Insecticide storage
Direction from well? How many feet?

Table with columns: FROM, TO, CODE, LITHOLOGIC LOG, FROM, TO, PLUGGING INTERVALS.
Row 1: 0, 2, Topsoil
Row 2: 2, 35, Silty Clay
Row 3: 35, TD, End of Borehole
Row 4: Gold Tag #: 0048875

7 CONTRACTOR'S OR LANDOWNER'S CERTIFICATION: This water well was (x) constructed, (2) reconstructed, or (3) plugged under my jurisdiction and was completed on (mo/day/yr) 07/07/14 And this record is true to the best of my knowledge and belief. Kansas
Water Well Contractor's License No. 585 This Water Well Record was completed on (mo/day/yr) 07/31/14
under the business name of Associated Environmental, Inc. By (signature) Bradley J. Johnson
INSTRUCTIONS: Please fill in blanks and circle the correct answers. Send three copies to Kansas Department of Health and Environment, Bureau of Water, Topeka, Kansas 66620-0001. Telephone: 913-296-5545. Send one to WATER WELL OWNER and retain one for your records.

OFFICE USE ONLY

T R

SEC