


1	LOCATION OF WATER WELL:	Fraction	Section Number	Township Number	Range Number
County: <b>Kearny</b>	<b>SW ¼ SW ¼ SE ¼</b>	<b>22</b>	<b>24</b>	<b>36</b>	<b>EW</b>

Distance and direction from nearest town or city street address of well if located within city?  
 516 N. Main, Lakin

2	WATER WELL OWNER: <b>Presta Oil</b>	Board of Agriculture, Division of Water Resources
	<b>14008 Reeder St.</b>	Application Number:
	RR #, St. Address, Box #: City, State, ZIP Code : <b>Overland Park, KS 66221</b>	

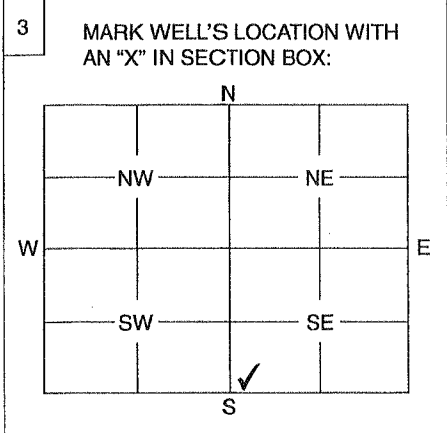

4 DEPTH OF WELL 23.45 ft.

WELL'S STATIC WATER LEVEL DRY ft.

WELL WAS USED AS:

1 Domestic	5 Public Water Supply	9 Dewatering
2 Irrigation	6 Oil Field Water Supply	<input checked="" type="checkbox"/> Monitoring Well MW-1
3 Feedlot	7 Domestic (Lawn & Garden)	11 Injection Well
4 Industrial	8 Air Conditioning	12 Other .....

Was a chemical / bacteriological sample submitted to Department? Yes ..... No  .....

If yes, mo/day/yr sample was submitted .....

Water Well Disinfected: Yes ..... No  .....

5 TYPE OF BLANK CASING USED:

1 Steel	3 RMP (SR)	5 Wrought	7 Fiberglass	9 Other (Specify below)
<input checked="" type="checkbox"/> PVC	4 ABS	6 Asbestos-Cement	8 Concrete Tile	

Blank casing diameter 2" in. Was casing pulled? Yes  No ..... If yes, how much 3'

Casing height above or below land surface 36 in.

6 GROUT PLUG MATERIAL: 1 Neat cement 2 Cement grout  Bentonite 4 Other .....

Grout Plug Intervals: From 3 ft. to 23.45 ft., From ..... ft. to ..... ft., From ..... to ..... ft.

- What is the nearest source of possible contamination:
- |                          |                   |                         |                          |
|--------------------------|-------------------|-------------------------|--------------------------|
| 1 Septic tank            | 6 Seepage pit     | 11 Fuel storage         | 16 Other (specify below) |
| 2 Sewer lines            | 7 Pit privy       | 12 Fertilizer storage   |                          |
| 3 Watertight sewer lines | 8 Sewage lagoon   | 13 Insecticide storage  |                          |
| 4 Lateral lines          | 9 Feedyard        | 14 Abandoned water well |                          |
| 5 Cess pool              | 10 Livestock pens | 15 Oil well/Gas well    |                          |

Direction from well? ..... How many feet? .....

FROM	TO	PLUGGING MATERIALS
0	0.5	concrete
0.5	3	native soil
3	23.45	bentonite grout

7 CONTRACTOR'S OF LANDOWNER'S CERTIFICATION: This water well was plugged under my jurisdiction and was completed on (mo/day/year) 10/1/14 and this record is true to the best of my knowledge and belief. Kansas Water Well Contractor's License No. 735. This Water Well Record was completed on (mo/day/year) 10/14/14 under the business name of MILCO Environmental Services, Inc.

by (signature) *[Signature]*