


1 LOCATION OF WATER WELL: County: KEARNY Fraction: NW 1/4 NW 1/4 SE 1/4 Section Number: 5 Township Number: T 24 S Range Number: R 37 EW

Distance and direction from nearest town or city street address of well if located within city?
1 1/2 MILES NORTHWEST OF LAKIN CITY

2 WATER WELL OWNER: GORDON & MARTHA BARNHARDT
RR#, St. Address, Box #: BOX 188 Board of Agriculture, Division of Water Resources
City, State, ZIP Code: BUCKLIN, KANSAS 67834 Application Number:

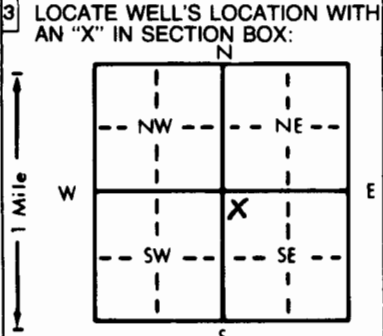

4 DEPTH OF COMPLETED WELL: 280 ft. ELEVATION:
Depth(s) Groundwater Encountered 1. 220 ft. 2. ft. 3. ft.
WELL'S STATIC WATER LEVEL: ft. below land surface measured on mo/day/yr
Pump test data: Well water was ft. after hours pumping gpm
Est. Yield gpm: Well water was ft. after hours pumping gpm
Bore Hole Diameter: in. to ft., and in. to ft.
WELL WATER TO BE USED AS:
1 Domestic 2 Irrigation 3 Feedlot 4 Industrial 5 Public water supply 6 Oil field water supply 7 Lawn and garden only 8 Air conditioning 9 Dewatering 10 Monitoring well 11 Injection well 12 Other (Specify below)
Was a chemical/bacteriological sample submitted to Department? Yes No X If yes, mo/day/yr sample was submitted Water Well Disinfected? Yes X No

5 TYPE OF BLANK CASING USED:
1 Steel 2 PVC 3 RMP (SR) 4 ABS 5 Wrought iron 6 Asbestos-Cement 7 Fiberglass 8 Concrete tile 9 Other (specify below) CASING JOINTS: Glued Clamped X Welded Threaded
Blank casing diameter 16 in. to ft. Dia. in. to ft. Dia. in. to ft.
Casing height above land surface 6 in. weight lbs./ft. Wall thickness or gauge No.
TYPE OF SCREEN OR PERFORATION MATERIAL:
1 Steel 2 Brass 3 Stainless steel 4 Galvanized steel 5 Fiberglass 6 Concrete tile 7 PVC 8 RMP (SR) 9 ABS 10 Asbestos-cement 11 Other (specify) NA 12 None used (open hole)
SCREEN OR PERFORATION OPENINGS ARE:
1 Continuous slot 2 Louvered shutter 3 Mill slot 4 Key punched 5 Gauzed wrapped 6 Wire wrapped 7 Torch cut 8 Saw cut 9 Drilled holes 10 Other (specify) NA 11 None (open hole)
SCREEN-PERFORATED INTERVALS: From NA ft. to NA ft. From ft. to ft. From ft. to ft.
GRAVEL PACK INTERVALS: From ft. to ft. From ft. to ft. From ft. to ft.

6 GROUT MATERIAL: 1 Neat cement 2 Cement grout 3 Bentonite 4 Other
Grout Intervals: From 6 ft. to 3 ft. From ft. to ft. From ft. to ft.
What is the nearest source of possible contamination:
1 Septic tank 2 Sewer lines 3 Watertight sewer lines 4 Lateral lines 5 Cess pool 6 Seepage pit 7 Pit privy 8 Sewage lagoon 9 Feedyard 10 Livestock pens 11 Fuel storage 12 Fertilizer storage 13 Insecticide storage 14 Abandoned water well 15 Oil well/Gas well 16 Other (specify below)
Direction from well? 1/2 MILE EAST OF WELL How many feet?

FROM	TO	LITHOLOGIC LOG	FROM	TO	PLUGGING INTERVALS
280'	215'	SAND			
215'	6'	DIRT/CLAY			
6'	3'	BENTONITE			
3'	0'	FILL DIRT			

7 CONTRACTOR'S OR LANDOWNER'S CERTIFICATION: This water well was (1) constructed, (2) reconstructed, or (3) plugged under my jurisdiction and was completed on (mo/day/year) 6-29-1993 and this record is true to the best of my knowledge and belief. Kansas Water Well Contractor's License No. This Water Well Record was completed on (mo/day/yr) 8-2-1993 under the business name of by (signature) Martha Barnhardt

INSTRUCTIONS: Use typewriter or ball point pen. PLEASE PRESS FIRMLY and PRINT clearly. Please fill in blanks, underline or circle the correct answers. Send top three copies to Kansas Department of Health and Environment, Bureau of Water, Topeka, Kansas 66620-0001. Telephone: 913-296-5545. Send one to WATER WELL OWNER and retain one for your records.