


WATER WELL RECORD Form WWC-5 KSA 82a-1212

1 LOCATION OF WELL: Fraction Section Number Township Number Range Number
 COUNTY: KEARNEY SE 1/4 SE 1/4 SW 1/4 15 T 24 S R 37 W

Distance and direction from nearest town or city street address of well if located within city?
 FROM LAKIN - 6 W DR HIGHWAY 50 TO K RD - 1 N, 1/2 E.

2 WATER WELL OWNER: MITCHELL, JERRY
 RR#, St. Address, Box #: 427 ROAD 50 Board of Agriculture, Division of Water Resources
 City, State, ZIP code: ULYSSES, KS 67880- Application Number:

3 LOCATE WELL'S LOCATION WITH AN "X" IN SECTION BOX:

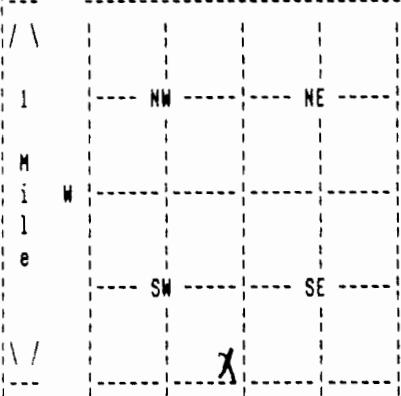

4 DEPTH OF COMPLETED WELL 397 ELEVATION: 0
 Depth(s) Groundwater Encountered 1. 0 ft. 2. 0 ft. 3. 0 ft.

WELL'S STATIC WATER LEVEL 160 ft. below land surface measured on mo/day/yr 06/02/10
 Pump test data: Well water was 0 ft. after 0 hours pumping 0 gpm

Estimated Yield 30 gpm: Well water was 0 ft. after 0 hours pumping 0 gpm

Bore Hole Diameter 9 in. to 397 ft., and in. to 0 ft.

WELL WATER TO BE USED AS: DOMESTIC

Was a chemical/bacteriological sample submitted to department? No;
 If yes, mo/day/yr sample was submitted Water well disinfected? Yes

5 TYPE OF BLANK CASING USED: CERTA LOC CASIN CASING JOINTS: CERTA-LOC
 Blank casing diameter 5 in. to 397 ft., Dia in. to 0 ft., Dia in. to 0 ft.
 Casing height above land surface 12 in., weight 200 lbs/ft. Wall thickness or gauge No. 21 17
 TYPE OF SCREEN OR PERFORATION MATERIAL: PVC
 SCREEN OR PERFORATION OPENINGS ARE: SAW CUT

SCREEN PERFORATED INTERVALS: From 172 ft. to 192 ft., From 0 ft. to 0 ft.
 From 312 ft. to 392 ft., From 0 ft. to 0 ft.
 GRAVEL PACK INTERVALS: From 25 ft. to 392 ft., From 0 ft. to 0 ft.
 From 0 ft. to 0 ft., From 0 ft. to 0 ft.

6 GROUT MATERIAL BENTONITE
 Grout Intervals: From 5 ft. to 25 ft., From 0 ft. to 0 ft., From 0 ft. to 0 ft.
 What is the nearest source of possible contamination: NONE
 Direction from well? How many feet? 0

FROM	TO	LITHOLOGIC LOG	FROM	TO	PLUGGING INTERVALS
0	20	01 TOPSOIL 02 FINE SAND			
20	40	10 FINE-MEDSAND 06 SMALL GRAVEL			
40	60	32 TAN CLAY			
60	80	32 TAN CLAY 37 FIN-COAR SAN			
80	100	37 FIN-COAR SAN 05 CLAY 19 LAYERS			
100	120	10 FINE-MEDSAND			
120	140	10 FINE-MEDSAND 04 COARSE SAND			
140	160	10 FINE-MEDSAND 05 CLAY 19 LAYERS			
160	190	10 FINE-MEDSAND			
190	300	07 BLUE SHALE			

7 CONTRACTOR'S OR LANDOWNER'S CERTIFICATION: This water well was Constructed under my jurisdiction and was completed on (mo/day/year) 06/03/10 and this record is true to the best of my knowledge and belief. Kansas Water Well Contractor's License No. 179 This Water Well Record was completed on (mo/day/yr) 06/23/10 under the business name of JOE'S WELL SERVICE, INC. by (signature) *Justin Crick*

(Continued)

WATER WELL RECORD Form WWC-5 KSA 82a-1212

1 LOCATION OF WATER WELL:	Fraction	Section Number	Township Number	Range Number
COUNTY: KEARNEY	SE 1/4 SE 1/4 SW 1/4	15	T 24 S	R 37 W

2 WATER WELL OWNER: MITCHELL, JERRY
RR#, St. Address, Box #: 427 ROAD 50 Board of Agriculture, Division of Water Resources
City, State, ZIP code: ULYSSES, KS 67880- Application Number:

FROM	TO	LITHOLOGIC LOG
300	400	29 SANDSTONE

7 CONTRACTOR'S OR LANDOWNER'S CERTIFICATION: This water well was Constructed under my jurisdiction and was completed on (mo/day/year) 06/03/10 and this record is true to the best of my knowledge and belief. Kansas Water Well Contractor's License No. 179 This Water Well Record was completed on (mo/day/yr) 06/23/10 under the business name of JOE'S WELL SERVICE, INC. by (signature) *Judith Cuck*