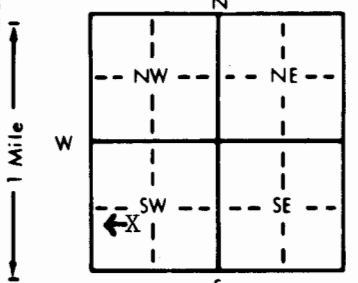


1 LOCATION OF WATER WELL: Fraction NW 1/4 SW 1/4 SW 1/4 Section Number 30 Township Number T 24 S Range Number R 38 E/W  
 County: KEARNY

Distance and direction from nearest town or city street address of well if located within city?  
 1/4 mi. southeast of Kendall, Kansas

2 WATER WELL OWNER: George E. Marrs  
 RR#, St. Address, Box #: Box 2 Board of Agriculture, Division of Water Resources  
 City, State, ZIP Code: Kendall, Kansas 67857 Application Number:

3 LOCATE WELL'S LOCATION WITH AN "X" IN SECTION BOX:  

 4 DEPTH OF COMPLETED WELL: 6.5' ft. ELEVATION: NA  
 Depth(s) Groundwater Encountered 1. NA ft. 2. NA ft. 3. NA ft.  
 WELL'S STATIC WATER LEVEL DRY . . . . . ft. below land surface measured on mo/day/yr Oct. 8, 1992  
 Pump test data: Well water was NA ft. after NA hours pumping NA gpm  
 Est. Yield NA gpm: Well water was NA ft. after NA hours pumping NA gpm  
 Bore Hole Diameter NA in. to NA ft., and NA in. to NA ft.  
 WELL WATER TO BE USED AS: 5 Public water supply 8 Air conditioning 11 Injection well  
 Domestic 3 Feedlot 6 Oil field water supply 9 Dewatering 12 Other (Specify below)  
 2 Irrigation 4 Industrial 7 Lawn and garden only 10 Monitoring well . . . . .  
 Was a chemical/bacteriological sample submitted to Department? Yes . . . . . No NA; If yes, mo/day/yr sample was submitted  
 Water Well Disinfected? Yes X No

5 TYPE OF BLANK CASING USED:  
 Steel 3 RMP (SR) 5 Wrought iron 8 Concrete tile CASING JOINTS: Glued . . . . . Clamped . . . . .  
 2 PVC 4 ABS 6 Asbestos-Cement 9 Other (specify below) Welded . . . . .  
 7 Fiberglass . . . . . Threaded   
 Blank casing diameter 6" . . . . . in. to NA . . . . . ft., Dia NA . . . . . in. to NA . . . . . ft., Dia NA . . . . . in. to NA . . . . . ft.  
 Casing height above land surface 3 feet . . . . . in., weight NA . . . . . NA lbs./ft. Wall thickness or gauge No. NA . . . . .  
 TYPE OF SCREEN OR PERFORATION MATERIAL:  
 1 Steel 3 Stainless steel 5 Fiberglass 8 RMP (SR) 10 Asbestos-cement 11 Other (specify) NA . . . . .  
 2 Brass 4 Galvanized steel 6 Concrete tile 9 ABS 12 None used (open hole)  
 SCREEN OR PERFORATION OPENINGS ARE:  
 1 Continuous slot 3 Mill slot 5 Gauzed wrapped 8 Saw cut 11 None (open hole)  
 2 Louvered shutter 4 Key punched 6 Wire wrapped 9 Drilled holes  
 7 Torch cut 10 Other (specify) NA . . . . .  
 SCREEN-PERFORATED INTERVALS: From NA . . . . . ft. to NA . . . . . ft., From NA . . . . . ft. to NA . . . . . ft.  
 From NA . . . . . ft. to NA . . . . . ft., From NA . . . . . ft. to NA . . . . . ft.  
 GRAVEL PACK INTERVALS: From NA . . . . . ft. to NA . . . . . ft., From NA . . . . . ft. to NA . . . . . ft.  
 From NA . . . . . ft. to NA . . . . . ft., From NA . . . . . ft. to NA . . . . . ft.

6 GROUT MATERIAL: 1 Neat cement 2 Cement grout XX 3 Bentonite 4 Other . . . . .  
 Grout Intervals: From 6 . . . . . ft. to 3 . . . . . ft., From NA . . . . . ft. to NA . . . . . ft., From NA . . . . . ft. to NA . . . . . ft.  
 What is the nearest source of possible contamination:  
 1 Septic tank 4 Lateral lines 7 Pit privy 10 Livestock pens 14 Abandoned water well  
 2 Sewer lines 5 Cess pool 8 Sewage lagoon 11 Fuel storage 15 Oil well/Gas well  
 3 Watertight sewer lines 6 Seepage pit 9 Feedyard 12 Fertilizer storage 16 Other (specify below)  
 13 Insecticide storage Pesticide and herbicide spray and runoff.

Direction from well? Next to and all around How many feet?

FROM	TO	LITHOLOGIC LOG	FROM	TO	PLUGGING INTERVALS
6.5'	6'	Sand			
6'	3'	Bentonite			
3'	0'	Dirt			

7 CONTRACTOR'S OR LANDOWNER'S CERTIFICATION: This water well was (1) constructed, (2) reconstructed, or  plugged under my jurisdiction and was completed on (mo/day/year) Dec. 8, 1992 . . . . . and this record is true to the best of my knowledge and belief. Kansas Water Well Contractor's License No. NA . . . . . This Water Well Record was completed on (mo/day/yr) 1/13/93 . . . . . under the business name of George E. Marrs by (signature) George E. Marrs

INSTRUCTIONS: Use typewriter or ball point pen. PLEASE PRESS FIRMLY and PRINT clearly. Please fill in blanks, underline or circle the correct answers. Send top three copies to Kansas Department of Health and Environment, Bureau of Water, Topeka, Kansas 66620-0001. Telephone: 913-296-5545. Send one to WATER WELL OWNER and retain one for your records.

OFFICE USE ONLY  
T  
R  
E/W  
SEC.  
1/4  
1/4