


1 LOCATION OF WATER WELL: Fraction NE 1/4 NE 1/4 SW 1/4 Section Number 30 Township Number T 24 S Range Number R 38 EW

Distance and direction from nearest town or city street address of well if located within city?  
 1/2 mi. east of Kendall, Kansas

2 WATER WELL OWNER: George E. Marrs  
 RR#, St. Address, Box #: Box 2 Board of Agriculture, Division of Water Resources  
 City, State, ZIP Code: Kendall, Kansas 67857 Application Number:

3 LOCATE WELL'S LOCATION WITH AN "X" IN SECTION BOX:

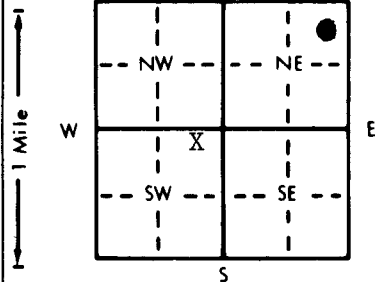

4 DEPTH OF COMPLETED WELL: 29' ft. ELEVATION: NA  
 Depth(s) Groundwater Encountered 1. NA ft. 2. NA ft. 3. NA ft.  
 WELL'S STATIC WATER LEVEL: Dry NA ft. below land surface measured on mo/day/yr Oct. 8, 1992  
 Pump test data: Well water was NA ft. after NA hours pumping NA gpm  
 Est. Yield NA gpm: Well water was NA ft. after NA hours pumping NA gpm  
 Bore Hole Diameter NA in. to NA ft., and NA in. to NA ft.  
 WELL WATER WAS USED AS: 5 Public water supply 8 Air conditioning 11 Injection well  
 1 Domestic 3 Feedlot 6 Oil field water supply 9 Dewatering 12 Other (Specify below)  
 2 Irrigation 4 Industrial 7 Lawn and garden only 10 Monitoring well NA  
 Was a chemical/bacteriological sample submitted to Department? Yes No.  If yes, mo/day/yr sample was submitted NA Water Well Disinfected? Yes  No

5 TYPE OF BLANK CASING USED: 1 Steel 3 RMP (SR) 5 Wrought iron 8 Concrete tile CASING JOINTS: Glued Clamped  
 2 PVC 4 ABS 6 Asbestos-Cement 9 Other (specify below) Welded  
 7 Fiberglass Threaded   
 Blank casing diameter 6 inches in. to NA ft., Dia NA in. to NA ft., Dia NA in. to NA ft.  
 Casing height above land surface 3 feet NA in., weight NA lbs./ft. Wall thickness or gauge No. NA

TYPE OF SCREEN OR PERFORATION MATERIAL: 1 Steel 3 Stainless steel 5 Fiberglass 8 RMP (SR) 11 Other (specify) NA  
 2 Brass 4 Galvanized steel 6 Concrete tile 9 ABS 12 None used (open hole)

SCREEN OR PERFORATION OPENINGS ARE: 5 Gauzed wrapped 8 Saw cut 11 None (open hole)  
 1 Continuous slot 3 Mill slot 6 Wire wrapped 9 Drilled holes  
 2 Louvered shutter 4 Key punched 7 Torch cut 10 Other (specify) NA

SCREEN-PERFORATED INTERVALS: From NA ft. to NA ft., From NA ft. to NA ft.  
 GRAVEL PACK INTERVALS: From NA ft. to NA ft., From NA ft. to NA ft.

6 GROUT MATERIAL: 1 Neat cement 2 Cement grout XX3 Bentonite 4 Other  
 Grout Intervals: From 6 ft. to 3 ft., From NA ft. to NA ft., From NA ft. to NA ft.

What is the nearest source of possible contamination: 10 Livestock pens 14 Abandoned water well  
 1 Septic tank 4 Lateral lines 7 Pit privy 11 Fuel storage 15 Oil well/Gas well  
 2 Sewer lines 5 Cess pool 8 Sewage lagoon 12 Fertilizer storage 16 Other (specify below)  
 3 Watertight sewer lines 6 Seepage pit 9 Feedyard 13 Insecticide storage Insecticide add herbicide crop spraying

Direction from well? Within 1/4 mile to east and south How many feet?

FROM	TO	LITHOLOGIC LOG	FROM	TO	PLUGGING INTERVALS
29'	27'	Sand			
27'	6'	Dirt/clay			
6'	3'	Bentonite			
3'	0'	Dirt			

7 CONTRACTOR'S OR LANDOWNER'S CERTIFICATION: This water well was (1) constructed, (2) reconstructed, or  plugged under my jurisdiction and was completed on (mo/day/year) 12/8/92 and this record is true to the best of my knowledge and belief. Kansas Water Well Contractor's License No. NA This Water Well Record was completed on (mo/day/yr) 1/13/93 under the business name of George E. Marrs by (signature) George E. Marrs

INSTRUCTIONS: Use typewriter or ball point pen. PLEASE PRESS FIRMLY and PRINT clearly. Please fill in blanks, underline or circle the correct answers. Send top three copies to Kansas Department of Health and Environment, Bureau of Water, Topeka, Kansas 66620-0001. Telephone: 913-296-5545. Send one to WATER WELL OWNER and retain one for your records.