


1 LOCATION OF WATER WELL: County: KEARNY Fraction SE 1/4 SE 1/4 NE 1/4 Section Number 32 Township Number T 24 S Range Number R 38 EW

Distance and direction from nearest town or city street address of well if located within city?
 APPROXIMATELY 2 MILES EAST OF KENDALL, KANSAS, ALONG THE RIVER ROAD

2 WATER WELL OWNER: Becky Grusing
 RR#, St. Address, Box #: Kendall, Kansas 67857
 City, State, ZIP Code: Board of Agriculture, Division of Water Resources
 Application Number:

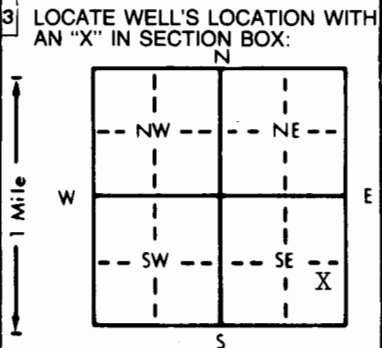

4 DEPTH OF COMPLETED WELL: 20 ft. ELEVATION: NA
 Depth(s) Groundwater Encountered 1. Dry ft. 2. NA ft. 3. NA ft.
 WELL'S STATIC WATER LEVEL: Dry ft. below land surface measured on mo/day/yr 10/8/92
 Pump test data: Well water was NA ft. after NA hours pumping NA gpm
 Est. Yield NA gpm: Well water was NA ft. after NA hours pumping NA gpm
 Bore Hole Diameter NA in. to NA ft., and NA in. to NA ft.
 WELL WATER TO BE USED AS:
 1 Domestic 3 Feedlot 6 Oil field water supply 9 Dewatering 12 Other (Specify below) NA
 2 Irrigation 4 Industrial 7 Lawn and garden only 10 Monitoring well NA
 Was a chemical/bacteriological sample submitted to Department? Yes NA No NA; If yes, mo/day/yr sample was submitted NA Water Well Disinfected? Yes NA No

5 TYPE OF BLANK CASING USED:
 1 Steel 3 RMP (SR) 5 Wrought iron 8 Concrete tile CASING JOINTS: Glued Clamped
 2 PVC 4 ABS 6 Asbestos-Cement 9 Other (specify below) Welded
 7 Fiberglass NA Threaded
 Blank casing diameter 6 in. to NA ft., Dia NA in. to NA ft., Dia NA in. to NA ft.
 Casing height above land surface 3 ft. below in., weight NA NA lbs./ft. Wall thickness or gauge No. NA
 TYPE OF SCREEN OR PERFORATION MATERIAL:
 1 Steel 3 Stainless steel 5 Fiberglass 8 RMP (SR) 11 Other (specify) NA
 2 Brass 4 Galvanized steel 6 Concrete tile 9 ABS 12 None used (open hole)
 SCREEN OR PERFORATION OPENINGS ARE:
 1 Continuous slot 3 Mill slot 5 Gauzed wrapped 8 Saw cut 11 None (open hole)
 2 Louvered shutter 4 Key punched 6 Wire wrapped 9 Drilled holes
 7 Torch cut 10 Other (specify) NA
 SCREEN-PERFORATED INTERVALS: From NA ft. to NA ft., From NA ft. to NA ft.
 GRAVEL PACK INTERVALS: From NA ft. to NA ft., From NA ft. to NA ft.

6 GROUT MATERIAL: 1 Neat cement 2 Cement grout 3 Bentonite 4 Other
 Grout Intervals: From 6 ft. to 3 ft., From NA ft. to NA ft., From NA ft. to NA ft.
 What is the nearest source of possible contamination:
 1 Septic tank 4 Lateral lines 7 Pit privy 10 Livestock pens 14 Abandoned water well
 2 Sewer lines 5 Cess pool 8 Sewage lagoon 11 Fuel storage 15 Oil well/Gas well
 3 Watertight sewer lines 6 Seepage pit 9 Feedyard 12 Fertilizer storage 16 Other (specify below)
 13 Insecticide storage Insecticide and herbicide spraying and livestock

Direction from well? All around next to → How many feet?

FROM	TO	LITHOLOGIC LOG	FROM	TO	PLUGGING INTERVALS
20'	19.5'	Sand/gravel, chlorine			
19.5'	6'	Dirt/clay			
6'	3'	Bentonite			
3'	0'	Fill Dirt			

7 CONTRACTOR'S OR LANDOWNER'S CERTIFICATION: This water well was (1) constructed, (2) reconstructed, or plugged under my jurisdiction and was completed on (mo/day/year) 12/30/92 and this record is true to the best of my knowledge and belief. Kansas Water Well Contractor's License No. NA This Water Well Record was completed on (mo/day/yr) 1/8/93 under the business name of Becky Grusing by (signature) Becky Grusing

INSTRUCTIONS: Use typewriter or ball point pen. PLEASE PRESS FIRMLY and PRINT clearly. Please fill in blanks, underline or circle the correct answers. Send top three copies to Kansas Department of Health and Environment, Bureau of Water, Topeka, Kansas 66620-0001. Telephone: 913-296-5545. Send one to WATER WELL OWNER and retain one for your records.

OFFICE USE ONLY
T
R
EW
SEC.
1/4
1/4