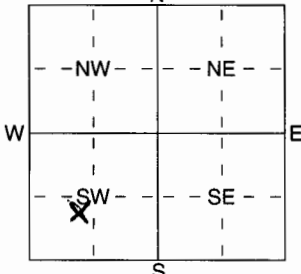


1 LOCATION OF WATER WELL: Fraction NE 1/4 SW 1/4 SW 1/4 Section Number 36 Township Number T 24 S Range Number R 38 E(W)  
 County: Kearny

Distance and direction from nearest town or city street address of well if located within city?

2 WATER WELL OWNER: George Bahntge  
 RR#, St. Address, Box # : Rt. #1 Box 15 Board of Agriculture, Division of Water Resources  
 City, State, ZIP Code : Lakin, KS 67860 Application Number:

3 LOCATE WELL'S LOCATION WITH AN "X" IN SECTION BOX:  
  
 4 DEPTH OF COMPLETED WELL 184 ft. ELEVATION: .....  
 Depth(s) Groundwater Encountered 1 ..... ft. 2 ..... ft. 3 ..... ft.  
 WELL'S STATIC WATER LEVEL 93 ft. below land surface measured on mo/day/yr 7-15-05  
 Pump test data: Well water was ..... ft. after ..... hours pumping ..... gpm  
 Est. Yield 12 gpm: Well water was ..... ft. after ..... hours pumping ..... gpm  
 WELL WATER TO BE USED AS: 5 Public water supply 8 Air conditioning 11 Injection well  
 1 Domestic 3 Feedlot 6 Oil field water supply 9 Dewatering ~~10 Other (Specify below)~~  
 2 Irrigation 4 Industrial 7 Domestic (lawn & garden) 10 Monitoring well Stack  
 Was a chemical/bacteriological sample submitted to Department? Yes ..... No  ..... If yes, mo/day/yr sample was submitted  
 Water Well Disinfected?  Yes No

5 TYPE OF BLANK CASING USED:  
 1 Steel 3 RMP (SR) 5 Wrought iron 8 Concrete tile CASING JOINTS: Glued  Clamped .....  
 PVC 4 ABS 6 Asbestos-Cement 9 Other (specify below) Welded .....  
 7 Fiberglass Threaded .....  
 Blank casing diameter 9 in. to 184 ft., Dia ..... in. to ..... ft., Dia ..... in. to ..... ft.  
 Casing height above land surface 12 in., weight ..... lbs./ft. Wall thickness or gauge No. 200 psi  
 TYPE OF SCREEN OR PERFORATION MATERIAL:  
 1 Steel 3 Stainless Steel 5 Fiberglass  PVC 10 Asbestos-Cement  
 2 Brass 4 Galvanized Steel 6 Concrete tile 8 RMP (SR) 11 Other (Specify) .....  
 9 ABS 12 None used (open hole)  
 SCREEN OR PERFORATION OPENINGS ARE:  
 1 Continuous slot 3 Mill slot 5 Gauzed wrapped  Saw cut 11 None (open hole)  
 2 Louvered shutter 4 Key punched 6 Wire wrapped 9 Drilled holes  
 7 Torch cut 10 Other (specify) ..... ft.  
 SCREEN-PERFORATED INTERVALS: From 124 ft. to 184 ft., From ..... ft. to ..... ft.  
 GRAVEL PACK INTERVALS: From 50 ft. to 184 ft., From ..... ft. to ..... ft.

6 GROUT MATERIAL: 1 Neat cement 2 Cement grout  Bentonite 4 Other .....  
 Grout Intervals: From 0 ft. to 50 ft., From ..... ft. to ..... ft., From ..... ft. to ..... ft.  
 What is the nearest source of possible contamination:  
 1 Septic tank 4 Lateral lines 7 Pit privy  Livestock pens 14 Abandoned water well  
 2 Sewer lines 5 Cess pool 8 Sewage lagoon 11 Fuel storage 15 Oil well/Gas well  
 3 Watertight sewer lines 6 Seepage pit 9 Feedyard 12 Fertilizer storage 16 Other (specify below)  
 13 Insecticide storage .....  
 Direction from well? How many feet? 500

FROM	TO	LITHOLOGIC LOG	FROM	TO	PLUGGING INTERVALS
0	2	top soil			
2	40	brown clay, sand streaks			
40	42	cledge			
42	50	yellow shale			
50	119	black shale			
119	139	sandstone			
139	142	sandstone, trace of shell streaks			
142	180	sandstone			
180	198	gray shale			

7 CONTRACTOR'S OR LANDOWNER'S CERTIFICATION: This water well was  constructed, (2) reconstructed, or (3) plugged under my jurisdiction and was completed on (mo/day/year) 7-15-05 and this record is true to the best of my knowledge and belief. Kansas Water Well Contractor's Licence No 532 This Water Well Record was completed on (mo/day/yr) 7-28-05 under the business name of Midwest Well & Pump Inc. by (signature) Heita Jueker