


WATER WELL RECORD Form WWC-5 KSA 82a-1212

LOCATION OF WATER WELL: COUNTY: HAMILTON Fraction NW 1/4 NW 1/4 SW 1/4 Section Number 21 Township Number T 24 S Range Number R 39 W

Distance and direction from nearest town or city street address of well if located within city? FROM SYRACUSE - 4 MILES EAST ON HIGHWAY 50 & 1 1/2 MILES NORTH

WATER WELL OWNER: MEDWAY CATTLE COMPANY RR#, St. Address, Box #: % GEORGE KOHMAN - BOX 52 City, State, ZIP code: SYRACUSE, KS 67878- Board of Agriculture, Division of Water Resources Application Number:

LOCATE WELL'S LOCATION WITH AN "X" IN SECTION BOX: 4 DEPTH OF COMPLETED WELL 465 ELEVATION: 0 Depth(s) Groundwater Encountered 1. 0 ft. 2. 0 ft. 3. 0 ft.

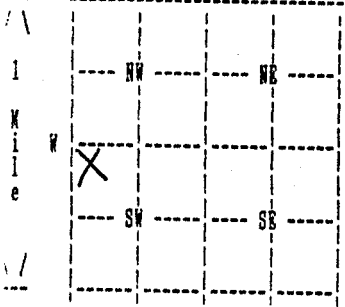

WELL'S STATIC WATER LEVEL 132 ft. below land surface measured on mo/day/yr 07/01/96 Pump test data: Well water was 0 ft. after 0 hours pumping 0 gpm

Estimated Yield 65 gpm: Well water was 0 ft. after 0 hours pumping 0 gpm

Bore Hole Diameter 10 in. to 465 ft., and in. to 0 ft.

WELL WATER TO BE USED AS: DOMESTIC

Was a chemical/bacteriological sample submitted to department? No; If yes, mo/day/yr sample was submitted Water well disinfected? Yes

TYPE OF BLANK CASING USED: PVC CASING JOINTS: GLUED Blank casing diameter 5 in. to 465 ft., Dia in. to 0 ft., Dia in. to 0 ft. Casing height above land surface 12 in., weight 200 lbs/ft. Wall thickness or gauge No. 21 17 TYPE OF SCREEN OR PERFORATION MATERIAL: PVC SCREEN OR PERFORATION OPENINGS ARE: SAW CUT

SCREEN PERFORATED INTERVALS: From 220 ft. to 260 ft., From 420 ft. to 460 ft. GRAVEL PACK INTERVALS: From 280 ft. to 300 ft., From 0 ft. to 0 ft. From 35 ft. to 465 ft., From 0 ft. to 0 ft. From 0 ft. to 0 ft., From 0 ft. to 0 ft.

GROUT MATERIAL BENTONITE Grout intervals: From 0 ft. to 35 ft., From 0 ft. to 0 ft., From 0 ft. to 0 ft. What is the nearest source of possible contamination: TRENCH & SILO Direction from well? WEST How many feet? 50

FROM	TO	LITHOLOGIC LOG	FROM	TO	PLUGGING INTERVALS
0	20	TOPSOIL FINE SAND			
20	40	FINE - MED SAND BLUE SHALE			
40	80	BLUE SHALE			
80	100	BLUE SHALE THIN ROCK LAYER			
100	120	BLUE SHALE GRAY CLAY SANDSTONE			
120	140	SANDSTONE GRAY CLAY			
140	300	GRAY CLAY THIN ROCK LAYER			
300	320	SANDSTONE			
320	340	SANDSTONE CLAY			
340	350	SANDSTONE IN LAYERS CLAY			

CONTRACTOR'S OR LANDOWNER'S CERTIFICATION: This water well was constructed under my jurisdiction and was completed on (mo/day/year) 07/02/96 and this record is true to the best of my knowledge and belief. Kansas Water Well Contractor's License No. 179 This Water Well Record was completed on (mo/day/yr) 08/29/96 under the business name of JOE'S WELL SERVICE, INC. by (signature) *Joe's Well Service*

(Continued) WATER WELL RECORD Form WWC-5 KSA 82a-1212

LOCATION OF WATER WELL: COUNTY: HAMILTON Fraction NW 1/4 NW 1/4 SW 1/4 Section Number 21 Township Number T 24 S Range Number R 39 W

WATER WELL OWNER: MEDWAY CATTLE COMPANY RR#, St. Address, Box #: % GEORGE KOHMAN - BOX 52 City, State, ZIP code: SYRACUSE, KS 67878- Board of Agriculture, Division of Water Resources Application Number:

FROM	TO	LITHOLOGIC LOG
350	360	ROCK LAYERS
360	380	ROCK LAYERS CLAY
380	420	BLUE SHALE ROCK LAYERS
420	440	CLAY SANDSTONE
440	460	SANDSTONE
460	480	GRAY CLAY SANDSTONE IN LAYERS