


1 LOCATION OF WATER WELL: County: **Hamilton** Fraction: **NE 1/4 SE 1/4 SE 1/4** Section Number: **25** Township Number: **T 24 S** Range Number: **R 39** E/W

Distance and direction from nearest town or city street address of well if located within city?  
**1/4 mile SE Coop, Railroad right a way, Kendall, KS**

2 WATER WELL OWNER: **Farmers Cooperative**  
 RR#, St. Address, Box # : **Box 189** Board of Agriculture, Division of Water Resources  
 City, State, ZIP Code : **Lakin, Kansas 67860** Application Number:

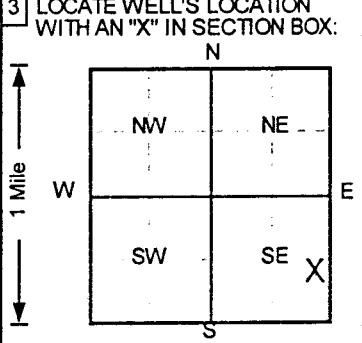

4 DEPTH OF COMPLETED WELL ..... **15** ..... ft. ELEVATION: ..... **3134.6** .....  
 Depth(s) Groundwater Encountered 1. .... **999** ..... ft. 2. .... ft. 3. .... ft.  
 WELL'S STATIC WATER LEVEL ..... **5.3** ..... ft. below land surface measured on mo/day/yr ..... **3/26/97** .....  
 Pump test data: Well water was ..... **NA** ..... ft. after ..... hours pumping ..... gpm  
 Est. Yield .. **NA** .. gpm: Well water was ..... ft. after ..... hours pumping ..... gpm  
 Bore Hole Diameter ..... **8** ..... in. to ..... **15** ..... ft., and..... in. to..... ft.  
 WELL WATER TO BE USED AS: 5 Public water supply 8 Air conditioning 11 Injection well  
 1 Domestic 3 Feedlot 6 Oil field water supply 9 Dewatering 12 Other (Specify below)  
 2 Irrigation 4 Industrial 7 Lawn and garden only 10 Monitoring well ..... **Monitoring well** .....  
 Was a chemical/bacteriological sample submitted to Department? Yes.....No  .....; If yes, mo/day/yr sample was submitted  
 Water Well Disinfected? Yes No

5 TYPE OF BLANK CASING USED:  
 1 Steel 3 RMP (SR) 5 Wrought iron 8 Concrete tile CASING JOINTS: Glued ..... Clamped .....  
 2 PVC 4 ABS 6 Asbestos-Cement 9 Other (specify below) Welded .....  
 7 Fiberglass ..... PVC Threaded.....  
 Blank casing diameter ..... **2** ..... in. to ..... **5** ..... ft., Dia ..... in. to ..... ft., Dia ..... in. to ..... ft.  
 Casing height above land surface ..... **40.44** ..... in., weight ..... lbs./ft. Wall thickness or gauge No. .... **Sch 40** .....  
 TYPE OF SCREEN OR PERFORATION MATERIAL 7 PVC 10 Asbestos-cement  
 1 Steel 3 Stainless steel 5 Fiberglass 8 RMP (SR) 11 Other (specify) . **PVC** .....  
 2 Brass 4 Galvanized steel 6 Concrete tile 9 ABS 12 None used (open hole)  
 SCREEN OR PERFORATION OPENINGS ARE:  
 1 Continuous slot 3 Mill slot 5 Gauzed wrapped 8 Saw cut 11 None (open hole)  
 2 Louvered shutter 4 Key punched 6 Wire wrapped 9 Drilled holes  
 7 Torch cut 10 Other (specify) **Mill Slot** .....  
 SCREEN-PERFORATED INTERVALS: From ..... **5** ..... ft. to ..... **15** ..... ft., From ..... ft. to ..... ft.  
 From ..... ft. to ..... ft., From ..... ft. to ..... ft.  
 GRAVEL PACK INTERVALS: From ..... **4** ..... ft. to ..... **15** ..... ft., From ..... ft. to ..... ft.  
 From ..... ft. to ..... ft., From ..... ft. to ..... ft.

6 GROUT MATERIAL: 1 Neat cement 2 Cement grout 3 Bentonite 4 Other **Bentonite** .....  
 Grout Intervals: From ..... **0** ..... ft. to ..... **2** ..... ft., From ..... **2** ..... ft. to ..... **4** ..... ft., From ..... ft. to ..... ft.  
 What is the nearest source of possible contamination:  
 1 Septic tank 4 Lateral lines 7 Pit privy 10 Livestock pens 14 Abandoned water well  
 2 Sewer lines 5 Cess pool 8 Sewage lagoon 11 Fuel storage 15 Oil well/Gas well  
 3 Watertight sewer lines 6 Seepage pit 9 Feedyard 12 Fertilizer storage 16 Other (specify below)  
 ..... **AST Basins** .....  
 Direction from well? **South** How many feet? **30**

LITHOLOGIC LOG			PLUGGING INTERVALS		
FROM	TO		FROM	TO	
0	6	Sand, Brown			
6	8	Sand, Brown			
8	15	Sand, Brown			
			MW3 , Tag # 00181770 , AboveGround		
			Project Name: Farmer's Coop - Kendall		
			GeoCore # 429 , KDHE # A1 038 40012		

7 CONTRACTOR'S OR LANDOWNER'S CERTIFICATION: This water well was 1 constructed, (2) reconstructed, or (3) plugged under my jurisdiction and was completed on (mo/day/year) ..... **3/25/97** ..... and this record is true to the best of my knowledge and belief.  
 Kansas Water Well Contractor's License No. .... **527** ..... This Water Well Record was completed on (mo/day/yr) **3/31/97** .....  
 under the business name of **GeoCore Services, Inc.** by (signature) *[Signature]*

INSTRUCTIONS: Use typewriter or ball point pen. PLEASE PRESS FIRMLY and PRINT clearly. Please fill in blanks, underline or circle the correct answers. Send top three copies to Kansas Department of Health and Environment, Bureau of Water, Topeka, Kansas 66620-0001. Telephone: 913-296-5545. Send one to WATER WELL OWNER and retain one for your records.

OFFICE USE ONLY  
T  
R  
EW  
SEC  
1/4  
1/4  
1/4