


USE TYPEWRITER OR BALL POINT PEN-PRESS FIRMLY, PRINT CLEARLY.

WATER WELL RECORD
KSA 82a-1201-1215

Kansas Department of Health and Environment-Division of Environment (Water well Contractors) Topeka, Kansas 66620

1. Location of well: County HAMILTON Fraction SW 1/4 SE 1/4 SE 1/4 Section number 11 Township number T 24 S R 39 E/W Range number

2. Distance and direction from nearest town or city: @ 2N 1W of Kendall
3. Owner of well: GARY COLBURN
Street address of well location if in city: Cow Trail Across pastures to location
R.R. or street:
City, state, zip code: Kendall Kansas

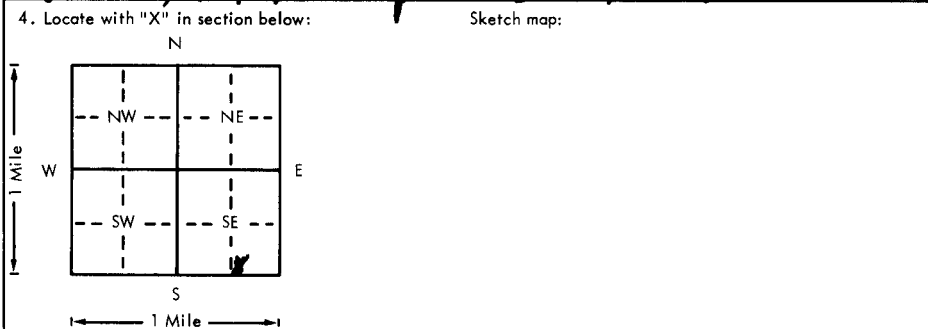

6. Bore hole dia. 2 7/8 in. Completion date 9-10-79
Well depth 297 ft.
7. Cable tool Rotary Driven Dug
 Hollow rod Jetted Bored Reverse rotary
8. Use: Domestic Public supply Industry
 Irrigation Air conditioning Stock
 Lawn Oil field water Other
9. Casing: Material STEEL Height: Above or below
Threaded Welded Surface 12 in.
RMP PVC Weight _____ lbs./ft.
Dia. 5 in. to 297 ft. depth Wall Thickness: inches or
Dia. _____ in. to _____ ft. depth gage No. 220

| 5. Type and color of material | From | To |
|-------------------------------|------------|------------|
| <u>SAND</u> | <u>0</u> | <u>33</u> |
| <u>Blue shale</u> | <u>33</u> | <u>178</u> |
| <u>Dakota Sand</u> | <u>178</u> | <u>230</u> |
| <u>Blue shale</u> | <u>230</u> | <u>260</u> |
| <u>DAKOTA SAND</u> | <u>260</u> | <u>297</u> |

10. Screen: Manufacturer's name SEE AND FOWELL
Type SALV Dia. 5"
Slot/gauze 5/32 Length 40
Set between 180 ft. and 220 ft.
260 ft. and 297 ft.
Gravel pack yes Size range of material CM-A
11. Static water level: _____ mo./day/yr.
170 ft. below land surface Date 9-11-79
12. Pumping level below land surfaces:
_____ ft. after _____ hrs. pumping _____ g.p.m.
_____ ft. after _____ hrs. pumping _____ g.p.m.
Estimated maximum yield 25 g.p.m.
13. Water sample submitted: _____ mo./day/yr.
 Yes No Date _____
14. Well head completion:
 Pitless adapter 12 inches above grade
15. Well grouted? yes
With: Neat cement Bentonite Concrete
Depth: From 0 ft. to 34 ft.
16. Nearest source of possible contamination:
ft. _____ Direction _____ Type _____
Well disinfected upon completion? Yes No
17. Pump: _____ Not installed
Manufacturer's name Goulds
Model number 135M HP 1 Volts 220
Length of drop pipe 200 ft. capacity 12 g.p.m.
Type:
 Submersible _____ Turbine
 Jet _____ Reciprocating
 Centrifugal _____ Other

18. Elevation _____
19. Remarks: 34' 8" surface set & cemented
Stock water well IN PASTURE
20. Water well contractor's certification:
This was drilled under my jurisdiction and this report is true to the best of my knowledge and belief.
Authorized representative