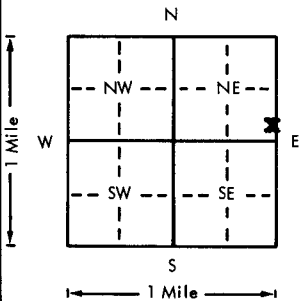


USE TYPEWRITER OR BALL POINT PEN—PRESS FIRMLY, PRINT CLEARLY.

WATER WELL RECORD  
KSA 82a-1201-1215

Kansas Department of Health and Environment—Division of Environment  
(Water well Contractors)  
Topeka, Kansas 66620

1. Location of well:		County <b>Hamilton Co.</b>	Fraction 1/4 1/4 <b>NE</b> 1/4	Section number <b>25</b>	Township number T <b>24 S.</b> S R	Range number R <b>39 E.</b> E/W
2. Distance and direction from nearest town or city: <b>In the city of Kendall 300' North of Railroad track, 100' West &amp; 45' East</b>			3. Owner of well: <b>Lakin Co-op</b> R.R. or street: City, state, zip code: <b>Lakin, KS. 67860</b>			
4. Locate with "X" in section below: Sketch map: 			6. Bore hole dia. <b>8"</b> in. Completion date <b>5-22-78</b> Well depth <b>154</b> ft.			
5. Type and color of material			7. <input type="checkbox"/> Cable tool <input type="checkbox"/> Rotary <input type="checkbox"/> Driven <input type="checkbox"/> Dug <input type="checkbox"/> Hollow rod <input type="checkbox"/> Jetted <input type="checkbox"/> Bored <input checked="" type="checkbox"/> Reverse rotary			
			8. Use: <input checked="" type="checkbox"/> Domestic <input type="checkbox"/> Public supply <input type="checkbox"/> Industry <input type="checkbox"/> Irrigation <input type="checkbox"/> Air conditioning <input type="checkbox"/> Stock <input type="checkbox"/> Lawn <input type="checkbox"/> Oil field water <input type="checkbox"/> Other			
			9. Casing: Material <b>Plastic</b> Height: Above or below Threaded <input type="checkbox"/> Welded <input type="checkbox"/> Surface <b>1 ft.</b> in. RMP <input type="checkbox"/> PVC <input checked="" type="checkbox"/> Weight <b>200 pressure</b> Dia. <b>5</b> in. to <b>154</b> ft. depth Wall Thickness: inches or Dia. <input type="checkbox"/> in. to <input type="checkbox"/> ft. depth gage No. <b>N/A</b>			
			10. Screen: Manufacturer's name <b>None</b> Type <input type="checkbox"/> Dia. <b>5/8</b> in. Slot/gauze Length <b>NONE</b> Set between <b>30' Perf.</b> and <input type="checkbox"/> ft. <input type="checkbox"/> ft. and <input type="checkbox"/> ft. Gravel pack? <input checked="" type="checkbox"/> Size range of material <b>4 - 5/8</b>			
			11. Static water level: <input type="checkbox"/> mo./day/yr. <b>12</b> ft. below land surface Date <b>5-22-78</b>			
			12. Pumping level below land surfaces: <input type="checkbox"/> ft. after <input type="checkbox"/> hrs. pumping <input type="checkbox"/> g.p.m. <input type="checkbox"/> ft. after <input type="checkbox"/> hrs. pumping <input type="checkbox"/> g.p.m. Estimated maximum yield <b>N/A</b> g.p.m.			
			13. Water sample submitted: <input type="checkbox"/> mo./day/yr. <input type="checkbox"/> Yes <input checked="" type="checkbox"/> No Date <input type="checkbox"/>			
			14. Well head completion: <input checked="" type="checkbox"/> Pitless adapter <b>1 ft.</b> inches above grade			
			15. Well grouted? <b>yes</b> With: <input type="checkbox"/> Neat cement <input type="checkbox"/> Bentonite <input checked="" type="checkbox"/> Concrete Depth: From <b>0</b> ft. to <b>10</b> ft.			
			16. Nearest source of possible contamination: ft. <input type="checkbox"/> Direction <b>1/2 mile S</b> Type <b>River</b> Well disinfected upon completion? <input checked="" type="checkbox"/> Yes <input type="checkbox"/> No			
(Use a second sheet if needed)			17. Pump: Not installed Manufacturer's name <b>Conida</b> Model number <b>25 FL</b> HP <b>1</b> Volts <input type="checkbox"/> Length of drop pipe <b>140</b> ft. capacity <b>26</b> g.p.m. Type: <input checked="" type="checkbox"/> Submersible <input type="checkbox"/> Turbine <input type="checkbox"/> Jet <input type="checkbox"/> Reciprocating <input type="checkbox"/> Centrifugal <input type="checkbox"/> Other			
18. Elevation:	19. Remarks:		20. Water well contractor's certification: This well was drilled under my jurisdiction and this report is true to the best of my knowledge and belief. <b>Minter-Wilson Drlg. Co. 208</b> Business name License No. Address <b>Box A, Garden City, KS. 67840</b> Signed <i>[Signature]</i> Date <b>5/2/78</b> Authorized representative			
Topography: <input type="checkbox"/> Hill <input type="checkbox"/> Slope <input type="checkbox"/> Upland <input checked="" type="checkbox"/> Valley						

T  
R  
W  
S  
E  
1/4  
1/4  
1/4

May 22, 1978

Lakin Kendall Coop  
(Robert Neese)  
Hamilton County

Location: From Test #1 45 feet east  
Static Water Level-12  
Test #3

0	1	Top Soil
1	12	Fine to med. sand and gravel loose
12	44	Med. coarse gravel loose
44	53	Shale
53	95	Sandstones 20% Shale hard
95	155	Sandstones hard
155	170	Shale hard
170	218	Gray Shale hard

Hole 154 feet  
5 inch PVC 200 plastic  
124 feet plain  
30 feet perf  
1 yard gravel  
1 bag of portland cement