


1 LOCATION OF WATER WELL: Fraction NE 1/4 NE 1/4 NE 1/4 Section Number 25 Township Number T 24 S Range Number R 39 EW  
 County: Hamilton

Distance and direction from nearest town or city street address of well if located within city?  
 Approx. 1/2 mile north of Kendall, KS

2 WATER WELL OWNER: Hamilton Co. RWD #1  
 RR#, St. Address, Box #: c/o White Hunsley & Assoc, Route 4, Box 26  
 City, State, ZIP Code: Salina, KS 67401  
 Board of Agriculture, Division of Water Resources  
 Application Number: not available

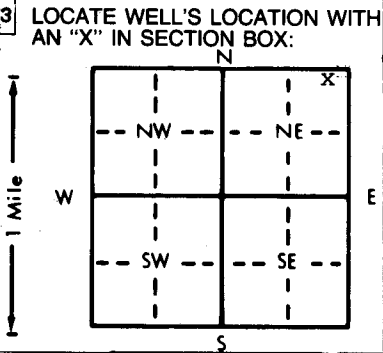

4 DEPTH OF COMPLETED WELL: 382 ft. ELEVATION: unknown  
 Depth(s) Groundwater Encountered 1 151.9' ft. 2. ft. 3. ft.  
 WELL'S STATIC WATER LEVEL 151.9' ft. below land surface measured on mo/day/yr 7-23-83  
 Pump test data: Well water was 181 ft. after 14 hours pumping 46 gpm  
 Est. Yield 46 gpm: Well water was ft. after hours pumping gpm  
 Bore Hole Diameter 12 1/2 in. to 396 ft., and in. to ft.  
 WELL WATER TO BE USED AS:  
 5 Public water supply 8 Air conditioning 11 Injection well  
 1 Domestic 3 Feedlot 6 Oil field water supply 9 Dewatering 12 Other (Specify below)  
 2 Irrigation 4 Industrial 7 Lawn and garden only 10 Observation well  
 Was a chemical/bacteriological sample submitted to Department? Yes No X; If yes, mo/day/yr sample was submitted  
 Water Well Disinfected? Yes X No

5 TYPE OF BLANK CASING USED:  
 1 Steel 3 RMP (SR) 5 Wrought iron 8 Concrete tile CASING JOINTS: Glued Clamped  
 2 PVC 4 ABS 6 Asbestos-Cement 9 Other (specify below) Welded  
 7 Fiberglass Threaded  
 Blank casing diameter 5 in. to 251 ft., Dia 5" to 272.75 in. to 5" to 372.5 ft., Dia 5" to 379.25 ft. to ft.  
 Casing height above land surface 24 in., weight 20.78 lbs./ft. Wall thickness or gauge No. 375  
 TYPE OF SCREEN OR PERFORATION MATERIAL:  
 1 Steel 3 Stainless steel 5 Fiberglass 8 RMP (SR) 10 Asbestos-cement 11 Other (specify)  
 2 Brass 4 Galvanized steel 6 Concrete tile 9 ABS 12 None used (open hole)  
 SCREEN OR PERFORATION OPENINGS ARE:  
 1 Continuous slot 3 Mill slot 5 Gauzed wrapped 8 Saw cut 11 None (open hole)  
 2 Louvered shutter 4 Key punched 6 Wire wrapped 9 Drilled holes  
 7 Torch cut 10 Other (specify) .030" slot  
 SCREEN-PERFORATED INTERVALS: From 251 ft. to 253.75 ft., From 372.5 ft. to 375.25 ft.  
 From 272.75 ft. to 275.5 ft., From 379.25 ft. to 382.0 ft.  
 GRAVEL PACK INTERVALS: From 198 ft. to 396 ft., From ft. to ft.

6 GROUT MATERIAL: 1 Neat cement\* 2 Cement grout 3 Bentonite 4 Other \*\*MudSeal  
 Grout Intervals: From \* 0 ft. to 20 ft., From \*\*20 ft. to 198 ft., From ft. to ft.  
 What is the nearest source of possible contamination:  
 1 Septic tank 4 Lateral lines 7 Pit privy 10 Livestock pens 14 Abandoned water well  
 2 Sewer lines 5 Cess pool 8 Sewage lagoon 11 Fuel storage 15 Oil well/Gas well  
 3 Watertight sewer lines 6 Seepage pit 9 Feedyard 12 Fertilizer storage 16 Other (specify below)  
 13 Insecticide storage Cemetery  
 Direction from well? East How many feet? approx. 100

FROM	TO	LITHOLOGIC LOG	FROM	TO	LITHOLOGIC LOG
0	12	04 Topsoil & sandy clay	285	288	19 Shale, gray
12	15	28 Rock-Limestone/S.S.?	288	291	01 Clay, Dakota
15	29	17 Sand & gravel	291	295	19 Shale, gray
29	186	19 Shale - blue	295	300	19 Clay, Dakota, white
186	189	23 Sandstone	300	341	01 Clay, Dakota, white, brown
189	191	Shale-blue	341	346	19 Shale, black
191	196	Shale w/sandstone streaks	346	358	01 Clay - white
196	240	19 Shale, Dakota clay	358	362	23 Sandstone w/clay streaks
240	245	23 Sandstone-Med-soft-clean	362	363	Shale - black
245	246	01 Clay - Dakota	363	365	Shale w/sandstone streaks
246	254	23 Sandstone, clean, soft	365	367	19 Shale, green, black
254	265	19 Shale - gray	367	385	23 Sandstone - soft
265	277	23 Sandstone - hard - clean	385	396	19 Shale - streak of sandstone @ 392'
277	284	01 Clay, white, Dakota			
284	285	23 Sandstone, soft			

7 CONTRACTOR'S OR LANDOWNER'S CERTIFICATION: This water well was (1) constructed, (2) reconstructed, or (3) plugged under my jurisdiction and was completed on (mo/day/year) 7/23/83 and this record is true to the best of my knowledge and belief. Kansas Water Well Contractor's License No. 185 This Water Well Record was completed on (mo/day/yr) 11-8-83 under the business name of CLARKE WELL & EQ., INC. by (signature) Clarke Well & Eq.

INSTRUCTIONS: Use typewriter or ball point pen, PLEASE PRESS FIRMLY and PRINT clearly. Please fill in blanks, underline or circle the correct answers. Send top three copies to Kansas Department of Health and Environment, Division of Environment, Environmental Geology Section, Topeka, KS 66620. Send one to WATER WELL OWNER and retain one for your records.

OFFICE USE ONLY

24 R

39 EW

SEC

25

12 1/4

12 1/4

D