USE TYPEWRITER OR BALL POINT PEN-PRESS FIRMLY, PRINT CLEARLY.

WATER WELL RECORD
KSA 82a-1201-1215

Kansas Department of Health and Environment-Division of Environment
(Water well Contractors)
Topeka, Kansas 66620

1. Location of well:	County	Fraction	Section number	Township number	Range number
	Hamilton	W½ 1/4 of 1/4 NE 1/4	32	T 24 S	R 39 E (W)

2. Distance and direction from nearest town or city: Approximately 2 3/4 mi SE of Mayline, Kansas.
Street address of well location if in city:

3. Owner of well: Eldon Hubbard
R.R. or street:
City, state, zip code: Kendall, Kansas 67857

4. Locate with "X" in section below: Sketch map:

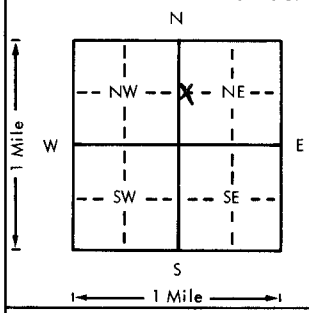

6. Bore hole dia. 9 7/8 in. Completion date 5/14/79
Well depth 35 ft.

7. __ Cable tool X Rotary __ Driven __ Dug
__ Hollow rod __ Jetted __ Bored __ Reverse rotary

8. Use: __ Domestic __ Public supply __ Industry
__ Irrigation __ Air conditioning X Stock
__ Lawn __ Oil field water __ Other

9. Casing: Material Plastic Height: (Above) or below
Threaded ___ Welded ___ Surface 12 in.
RMP ___ PVC X Weight 2.9 lbs./ft.
Dia. 5 in. to 35 ft. depth Wall Thickness: inches or
Dia. ___ in. to ___ ft. depth gage No. .265

5. Type and color of material	From	To
See Attachment		
(Use a second sheet if needed)		

10. Screen: Manufacturer's name Jet Stream
Type PVC Dia. 5"
(Slot)/gauze .040 Length 20'
Set between 15 ft. and 35 ft.
___ ft. and ___ ft.
Gravel pack? Yes Size range of material #1 Fine

11. Static water level: mo./day/yr.
31 ft. below land surface Date 5/14/79

12. Pumping level below land surface: Not Pumped
___ ft. after ___ hrs. pumping ___ g.p.m.
___ ft. after ___ hrs. pumping ___ g.p.m.
Estimated maximum yield 5 g.p.m.

13. Water sample submitted: mo./day/yr.
___ Yes X No Date

14. Well head completion:
___ Pitless adapter 12 Inches above grade

15. Well grouted? Yes
With: X Neat cement ___ Bentonite ___ Concrete
Depth: From 0 ft. to 10 ft.

16. Nearest source of possible contamination None Observed
ft. ___ Direction ___ Type
Well disinfected upon completion? ___ Yes X No

17. Pump: X Not installed
Manufacturer's name
Model number ___ HP ___ Volts ___
Length of drop pipe ___ ft. capacity ___ g.p.m.
Type:
___ Submersible ___ Turbine
___ Jet ___ Reciprocating
___ Centrifugal ___ Other

T R E W Sec 1/4 1/4 1/4

18. Elevation:

Topography:
___ Hill
X Slope
___ Upland
___ Valley

19. Remarks:

20. Water well contractor's certification:
This well was drilled under my jurisdiction and this report is true to the best of my knowledge and belief.
Henkle Drilling&Sply 145
Business name License No.
Address Box 639, Garden City, Ks
Signed Bruce J Richmuth Date 5/30/79
Authorized representative

Forward the white, blue and pink copies to the Department of Health and Environment

Form WWC-5

DRILLERS TEST LOG

CUSTOMERS NAME Eldon Hubbard DATE 5/14/79
STREET ADDRESS TEST # 1 E. LOG Yes
CITY & STATE Kendall, Kansas DRILLER Rector
COUNTY Hamilton QUARTER NE SECTION 32 TOWNSHIP 24 RANGE 39

LOCATION 1,320 ft. South of the NW corner of the ¼.

STOCK WELL LOCATION
Static Water Level 31 ft.
Proposed Well Depth 35ft.

%	FOOTAGE From	Pay	To	DESCRIPTION OF STRATA
	0		10	Sandy clay and sand
	10		30	Sand, gravel and cobblestones.
	30		40	Blue shale
				Casing Schedule: TOTAL DEPTH OF WELL 35 ft.
				35' to 15' - Perf.
				15' to 0' - Plain
				Used #1 Fine Gravel Pack