USE TYPEWRITER OR BALL POINT PEN-PRESS FIRMLY, PRINT CLEARLY.

WATER WELL RECORD
KSA 82a-1201-1215

Kansas Department of Health and Environment-Division of Environment
(Water well Contractors)
Topeka, Kansas 66620

ADA

1. Location of well:	County	Fraction	Section number	Township number	Range number
	Hamilton	NE 1/4 SE 1/4 NE 1/4	34	T ~~34~~ 24 S	R 39 E (W)

2. Distance and direction from nearest town or city: 1.5 W and .5 S of Kendall
Street address of well location if in city:

3. Owner of well: Roger Ramsey
R.R. or street: Imperial Route
City, state, zip code: Garden City, Kansas

4. Locate with "X" in section below:

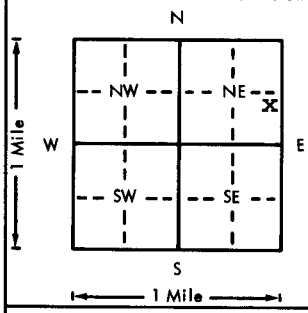

Sketch map:

330' W and 1320' N of SE corner of the NE¼, Sec. 34. T24S, R39W, Hamilton, Kansas

5. Type and color of material	From	To
Sandy Soil	0	2
Coarse sand	2	6
Boulders & coarse sand, medium gravel	6	62
Coarse sand medium gravel with boulders		
streaks	62	102
Black shale	102	110
BROCK 102'		

(Use a second sheet if needed)

6. Bore hole dia. 28 in. Completion date 22 May 76
Well depth 102 ft.

7. __ Cable tool __ Rotary __ Driven __ Dug
__ Hollow rod __ Jetted __ Bored x Reverse rotary

8. Use: __ Domestic __ Public supply __ Industry
x Irrigation __ Air conditioning __ Stock
__ Lawn __ Oil field water __ Other

9. Casing: Material Stl
Threaded ___ Welded x
RMP ___ PVC ___
Dia. 16 in. to 42 ft. depth
Dia. ___ in. to ___ ft. depth
Height: Above or below Surface 12 in.
Weight 37 lbs./ft.
Wall Thickness: inches or gage No. .219

10. Screen: Manufacturer's name Doerr
Type Louver Dia. 16"
Slot/gauze 1/8" Length 60
Set between 42 ft. and 102 ft.
___ ft. and ___ ft.
Gravel pack? x Size range of material 5.2mm

11. Static water level: mo./day/yr.
6 ft. below land surface Date 30 Apr. 76

12. Pumping level below land surfaces: Not Tested
___ ft. after ___ hrs. pumping ___ g.p.m.
___ ft. after ___ hrs. pumping ___ g.p.m.
Estimated maximum yield 2000 g.p.m.

13. Water sample submitted: mo./day/yr.
___ Yes x No Date

14. Well head completion:
___ Pitless adapter x Inches above grade

15. Well grouted? Yes
With: ___ Neat cement x Bentonite ___ Concrete
Depth: From 0 ft. to 10 ft.

16. Nearest source of possible contamination: Unk
ft. ___ Direction ___ Type ___
Well disinfected upon completion? x Yes ___ No

17. Pump: ___ Not installed
Manufacturer's name Layne & Bowler
Model number 12KL HP 75 Volts 460
Length of drop pipe 50 ft. capacity 800 g.p.m.
Type:
___ Submersible x Turbine
___ Jet ___ Reciprocating
___ Centrifugal ___ Other

18. Elevation:
Topography:
___ Hill
___ Slope
___ Upland
x Valley

19. Remarks: 3/4 (TCPO)

20. Water well contractor's certification:
This well was drilled under my jurisdiction and this report is true to the best of my knowledge and belief.
Layne-Western Co., Inc. 150
Business name License No.
Address Garden City, Kansas
Signed [signature] Date 26 May 76
Authorized representative

24 S 39 E 34 NE SE NE
T R Sec 1/4 1/4 1/4

Forward the white, blue and pink copies to the Department of Health and Environment

Form WWC-5