


1 LOCATION OF WATER WELL:	Fraction <u>South 1/2</u>	Section Number <u>25</u>	Township Number <u>24 S</u>	Range Number <u>39 W</u>
County: <u>Hamilton County KS</u>	1/4 1/4 1/4			E/W

Distance and direction from nearest town or city street address of well if located within city?

2 WATER WELL OWNER: <u>RAULPH J. SWORAS JR</u>	Board of Agriculture, Division of Water Resources
RR #, St. Address, Box #: <u>P.O. Box 333</u>	Application Number:
City, State, ZIP Code: <u>Garden City, KS 67846</u>	

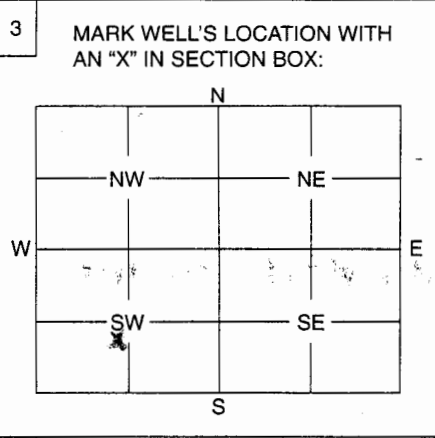

4 DEPTH OF WELL ..... 8 ..... ft.

WELL'S STATIC WATER LEVEL ..... 0 ..... ft. dry \*

WELL WAS USED AS:

1 Domestic	5 Public Water Supply	9 Dewatering
2 Irrigation	6 Oil Field Water Supply	10 Monitoring Well
3 Feedlot	7 Domestic (Lawn & Garden)	11 Injection Well
4 Industrial	8 Air Conditioning	12 Other <u>Livestock</u>

Was a chemical / bacteriological sample submitted to Department? Yes ..... No X .....

If yes, mo/day/yr sample was submitted .....

Water Well Disinfected: Yes X ..... No .....

5 TYPE OF BLANK CASING USED:

1 Steel	3 RMP (SR)	5 Wrought	7 Fiberglass	9 Other (Specify below) <u>old galvanized rod casing</u>
2 PVC	4 ABS	6 Asbestos-Cement	8 Concrete Tile	

Blank casing diameter ..... 5 ..... in. Was casing pulled? Yes ..... No ✓ ..... If yes, how much .....

Casing height above or below land surface ..... 91 ..... in.

6 GROUT PLUG MATERIAL: 1 Neat cement 2 Cement grout 3 Bentonite 4 Other .....

Grout Plug Intervals: From 3 ft. to 6 ft., From ..... ft. to ..... ft., From ..... ft. to ..... ft.

What is the nearest source of possible contamination: From surface

1 Septic tank	6 Seepage pit	11 Fuel storage	16 Other (specify below)
2 Sewer lines	7 Pit privy	12 Fertilizer storage	
3 Watertight sewer lines	8 Sewage lagoon	13 Insecticide storage	
4 Lateral lines	9 Feedyard	<u>14 Abandoned water well</u>	
5 Cess pool	10 Livestock pens	15 Oil well/Gas well	

Direction from well? 1/2 mile West How many feet? 175 feet

FROM	TO	PLUGGING MATERIALS
8	6	Subsoil
6	3	Bentonite Plug (top)
3	0	Top Soil

7 CONTRACTOR'S OF LANDOWNER'S CERTIFICATION: This water well was plugged under my jurisdiction and was completed on (mo/day/year) April 23 2005 and this record is true to the best of my knowledge and belief. Kansas Water Well Contractor's License No. .... This Water Well Record was completed on (mo/day/year) ..... under the business name of ..... by (signature) [Signature]

INSTRUCTIONS: Use typewriter or ball point pen. Please press firmly and print clearly. Please fill in blanks, underline or circle the correct answers. Send top three copies to Kansas Department of Health and Environment, Bureau of Water, Geology Section, 1000 SW Jackson St., Ste. 420, Topeka, Kansas 66612-1367. Telephone: 785/296-5522. Send one to Water Well Owner and retain one for your records.