


WATER WELL RECORD Form WWC-5 KSA 82a-1212

1 LOCATION OF WATER WELL: Fraction Section Number Township Number Range Number
 COUNTY: 038 HAMILTON SE 1/4 SE 1/4 NW 1/4 26 T 24 S R 39 W

Distance and direction from nearest town or city street address of well if located within city?
 FROM KENDALL; APPX 1 1/2 MILES WEST & 1/4 MILE SOUTH

2 WATER WELL OWNER: DR. RALPH SWORDS Board of Agriculture, Division of Water Resources
 RR#, St. Address, Box #: PO BOX 333 Application Number:
 City, State, ZIP code: GARDEN CITY, KS 67846-0333

3 LOCATE WELL'S LOCATION WITH AN "X" IN SECTION BOX:

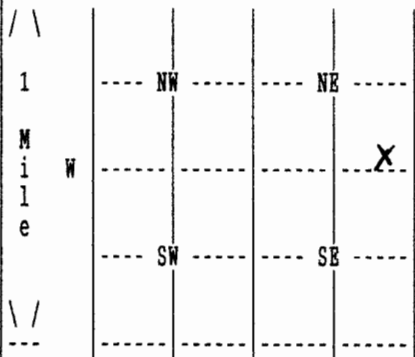

4 DEPTH OF COMPLETED WELL 280 ELEVATION: 0
 Depth(s) Groundwater Encountered 1. 0 ft. 2. 0 ft. 3. 0 ft.

WELL'S STATIC WATER LEVEL 47 ft. below land surface measured on mo/day/yr 07/06/05
 Pump test data: Well water was 0 ft. after 0 hours pumping 0 gpm

Estimated Yield 0 gpm: Well water was 0 ft. after 0 hours pumping 0 gpm

Bore Hole Diameter 12 1/4 in. to 250 ft., and in. to 0 ft.

WELL WATER TO BE USED AS: 01 DOMESTIC

Was a chemical/bacteriological sample submitted to department? No ;
 If yes, mo/day/yr sample was submitted Water well disinfected? Yes

5 TYPE OF BLANK CASING USED: 02 PVC CASING JOINTS: GLUED
 Blank casing diameter 5 in. to 280 ft., Dia in. to 0 ft., Dia in. to 0 ft.
 Casing height above land surface 12 in., weight 4 lbs/ft. Wall thickness or gauge No. .327
 TYPE OF SCREEN OR PERFORATION MATERIAL: 07 PVC
 SCREEN OR PERFORATION OPENINGS ARE: 03 MILL SLOT

SCREEN PERFORATED INTERVALS: From 110 ft. to 130 ft., From 0 ft. to 0 ft.
 From 150 ft. to 250 ft., From 0 ft. to 0 ft.
 GRAVEL PACK INTERVALS: From 25 ft. to 70 ft., From 0 ft. to 0 ft.
 From 80 ft. to 280 ft., From 0 ft. to 0 ft.

6 GROUT MATERIAL 03 BENTONITE
 Grout Intervals: From 5 ft. to 25 ft., From 70 ft. to 80 ft., From 0 ft. to 0 ft.
 What is the nearest source of possible contamination: NONE OBSERVED
 Direction from well? How many feet? 0

FROM	TO	LITHOLOGIC LOG	FROM	TO	PLUGGING INTERVALS
0	2	02 SILT			
2	5	01 CLAY			
5	40	05 SAND 15 CRS GRAVEL			
40	76	23 SANDSTONE			
76	100	31 CALICHE 23 SANDSTONE			
100	130	23 SANDSTONE 20 LIMESTONE			
130	150	23 SANDSTONE 19 SHALE			
150	250	19 SHALE 23 SANDSTONE			
250	280	19 SHALE 23 SANDSTONE			
280	280	23 SANDSTONE 31 CALICHE			

7 CONTRACTOR'S OR LANDOWNER'S CERTIFICATION: This water well was Constructed under my jurisdiction and was completed on (mo/day/year) 06/17/05 and this record is true to the best of my knowledge and belief. Kansas Water Well Contractor's License No. 145 This Water Well Record was completed on (mo/day/yr) 08/10/05 under the business name of HENKLE DRILLING & SUPPLY by (signature)

(Continued)

WATER WELL RECORD Form WWC-5 KSA 82a-1212

1 LOCATION OF WATER WELL: Fraction Section Number Township Number Range Number
COUNTY: 038 HAMILTON 1/4 26 T 24 S R 39 W

2 WATER WELL OWNER: DR. RALPH SWORDS
RR#, St. Address, Box # : PO BOX 333 Board of Agriculture, Division of Water Resources
City, State, ZIP code : GARDEN CITY, KS 67846-0333 Application Number:

FROM	TO	LITHOLOGIC LOG
240	280	31 CALICHE
280	360	19 SHALE
360	372	23 SANDSTONE
372	375	19 SHALE

7 CONTRACTOR'S OR LANDOWNER'S CERTIFICATION: This water well was Constructed under my jurisdiction and was completed on (mo/day/year) 06/17/05 and this record is true to the best of my knowledge and belief. Kansas
Water Well Contractor's License No. 145 This Water Well Record was completed on (mo/day/yr) 08/10/05
under the business name of HENKLE DRILLING & SUPPLY by (signature) *Bryan Henkle*