


1 LOCATION OF WATER WELL: Fraction Section Number Township Number Range Number
 COUNTY: 038 HAMILTON NW 1/4 NW 1/4 NW 1/4 21 T 24 S R 39 W

Distance and direction from nearest town or city street address of well if located within city?
 FROM MAYLINE, APPX 2 MILES EAST

2 WATER WELL OWNER: GEORGE KOHMAN Board of Agriculture, Division of Water Resources
 RR#, St. Address, Box #: PO BOX 52 Application Number: 42504 & 4940-01
 City, State, ZIP code: SYRACUSE, KS 67878-0052

3 LOCATE WELL'S LOCATION WITH AN "X" IN SECTION BOX: 4 DEPTH OF COMPLETED WELL 342 ELEVATION: 0
 Depth(s) Groundwater Encountered 1. 0 ft. 2. 0 ft. 3. 0 ft.

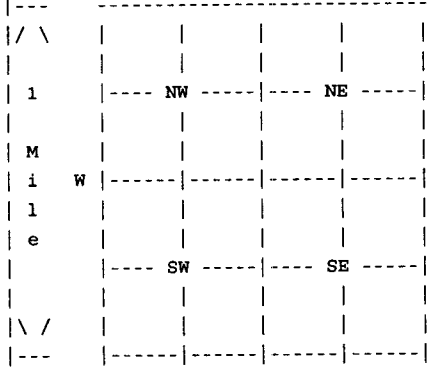

WELL'S STATIC WATER LEVEL 129 ft. below land surface measured on mo/day/yr 11/24/07
 Pump test data: Well water was 0 ft. after 0 hours pumping 0 gpm
 Estimated Yield 0 gpm: Well water was 0 ft. after 0 hours pumping 0 gpm
 Bore Hole Diameter 12 1/4 in. to 342 ft., and in. to 0 ft.
 WELL WATER TO BE USED AS: 03 Feedlot
 Was a chemical/bacteriological sample submitted to department? No ;
 If yes, mo/day/yr sample was submitted Water well disinfected? Yes

5 TYPE OF BLANK CASING USED: 02 PVC CASING JOINTS: OTHER - CERTZLOK
 Blank casing diameter 6 in. to 342 ft., Dia in. to 0 ft., Dia in. to 0 ft.
 Casing height above land surface 12 in., weight 4 lbs/ft. Wall thickness or gauge No. .316
 TYPE OF SCREEN OR PERFORATION MATERIAL: 07 PVC
 SCREEN OR PERFORATION OPENINGS ARE: 03 MILL SLOT

SCREEN PERFORATED INTERVALS: From 142 ft. to 242 ft., From 0 ft. to 0 ft.
 From 0 ft. to 0 ft., From 0 ft. to 0 ft.
 GRAVEL PACK INTERVALS: From 25 ft. to 342 ft., From 0 ft. to 0 ft.
 From 0 ft. to 0 ft., From 0 ft. to 0 ft.

6 GROUT MATERIAL 03 BENTONITE
 Grout Intervals: From 5 ft. to 25 ft., From 0 ft. to 0 ft., From 0 ft. to 0 ft.
 What is the nearest source of possible contamination: 14 ABAND. WELL
 Direction from well? SOUTHWEST How many feet? 293

FROM	TO	LITHOLOGIC LOG	FROM	TO	PLUGGING INTERVALS
0	2	02 SILT			
2	18	04 SANDY CLAY			
18	26	05 SAND 13 FINE GRAVEL			
26	28	04 SANDY CLAY			
28	30	31 CALICHE			
30	93	19 SHALE			
93	107	19 SHALE 23 SANDSTONE			
107	113	23 SANDSTONE			
113	131	23 SANDSTONE			
131	145	31 CALICHE			

7 CONTRACTOR'S OR LANDOWNER'S CERTIFICATION: This water well was Constructed under my jurisdiction and was completed on (mo/day/year) 11/21/06 and this record is true to the best of my knowledge and belief. Kansas
 Water Well Contractor's License No. 145 This Water Well Record was completed on (mo/day/yr) 05/02/07
 under the business name of HENKLE DRILLING & SUPPLY by (signature)

(Continued)

1 LOCATION OF WATER WELL: | Fraction | Section Number | Township Number | Range Number
COUNTY: 038 HAMILTON | NW 1/4 NW 1/4 NW 1/4 | 21 | T 24 S | R 39 W

2 WATER WELL OWNER: GEORGE KOHMAN
RR#, St. Address, Box # : PO BOX 52 Board of Agriculture, Division of Water Resources
City, State, ZIP code : SYRACUSE, KS 67878-0052 Application Number: 42504 & 4940-01

FROM	TO	LITHOLOGIC LOG
145	156	23 SANDSTONE
156	177	31 CALICHE
177	212	23 SANDSTONE 31 CALICHE
212	227	31 CALICHE
227	239	23 SANDSTONE
239	286	31 CALICHE 19 SHALE
286	337	23 SANDSTONE 31 CALICHE
337	400	19 SHALE

7 CONTRACTOR'S OR LANDOWNER'S CERTIFICATION: This water well was Constructed under my jurisdiction and was completed on (mo/day/year) 11/21/06 and this record is true to the best of my knowledge and belief. Kansas
Water Well Contractor's License No. 145 This Water Well Record was completed on (mo/day/yr) 05/02/07
under the business name of HENKLE DRILLING & SUPPLY by (signature) *Bruce J. Reckman*