


1 LOCATION OF WATER WELL:		Fraction	Center	SW	Section Number	Township Number	Range Number
County:	Beno	1/4	1/4	1/4	24	T 24 S	R 4 E (W)

Distance and direction from nearest town or city street address of well if located within city?
3 miles west 2 1/2 north of Haven

2 WATER WELL OWNER: Major Cokley
RR#, St. Address, Box # : 12013 E. Lake Table Rd.
City, State, ZIP Code : Haven, KS 67543

Board of Agriculture, Division of Water Resources
Application Number: 42360

3 LOCATE WELL'S LOCATION WITH AN "X" IN SECTION BOX: 4 DEPTH OF COMPLETED WELL: 70 ft. ELEVATION: 1500 ft.

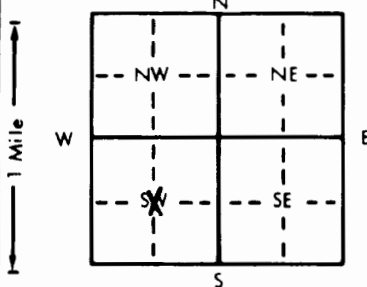

4) DEPTH OF COMPLETED WELL 70 ft. ELEVATION: 10
 Depth(s) Groundwater Encountered 1 ft. 2 ft. 3 ft.
 WELL'S STATIC WATER LEVEL 6 ft. below land surface measured on mo/day/yr 2-3-97
 Pump test data: Well water was _____ ft. after _____ hours pumping _____ gpm
 Est. Yield _____ gpm Well water was _____ ft. after _____ hours pumping _____ gpm
 Bore Hole Diameter 30 in. to 70 ft. and _____ in. to _____ ft.
 WELL WATER TO BE USED AS:
 1 Domestic 3 Feedlot 6 Oil field water supply 9 Dewatering 11 Injection well
2 Irrigation 4 Industrial 7 Lawn and garden only 10 Monitoring well
 Was a chemical/bacteriological sample submitted to Department? Yes _____ No X If yes, mo/day/yr sample was sub-
 mitted _____ Water Well Disinfected? Yes X No _____

5 TYPE OF BLANK CASING USED: 5 Wrought iron 8 Concrete tile CASING JOINTS: Glued ☒ Clamped ☐
1 Steel 3 RMP (SR) 6 Asbestos-Cement 9 Other (specify below) Welded ☐
2 PVC 4 ABS 7 Fiberglass Threaded ☐
Blank casing diameter 16 in. to 40 ft. Dia. in. to ft. Dia. in. to ft.
Casing height above land surface 18 in. weight sch 40 lbs./ft. Wall thickness or gauge No. 500

TYPE OF SCREEN OR PERFORATION MATERIAL:

1 Steel	3 Stainless steel	5 Fiberglass	7 PVC	10 Asbestos-cement
2 Brass	4 Galvanized steel	6 Concrete tile	8 RMP (SR)	11 Other (specify)
			9 ABS	12 None used (open hole)

SCREEN OR PERFORATION OPENINGS ARE:

1 Continuous slot	3 Mill slot	5 Gauzed wrapped	8 Saw cut	11 None (open hole)
2 Louvered shutter	4 Key punched	6 Wire wrapped	9 Drilled holes	
		7 Torch cut	10 Other (specify)	

SCREEN-PERFORATED INTERVALS: From 40 ft. to 70 ft. From _____ ft. to _____ ft.
From _____ ft. to _____ ft. From _____ ft. to _____ ft.
GRAVEL PACK INTERVALS: From 70 ft. to 15 ft. From _____ ft. to _____ ft.
From _____ ft. to _____ ft. From _____ ft. to _____ ft.

6 GROUT MATERIAL: 1 Neat cement 2 Cement grout 3 Bentonite 4 Other
Grout Intervals: From 15 ft. to 0 ft. From ft. to ft. From ft. to ft.

What is the nearest source of possible contamination:

1 Septic tank	4 Lateral lines	7 Pit privy	10 Livestock pens	14 Abandoned water well
2 Sewer lines	5 Cess pool	8 Sewage lagoon	11 Fuel storage	15 Oil well/Gas well
3 Watertight sewer lines	6 Seepage pit	9 Feedyard	12 Fertilizer storage	16 Other (specify below)
			13 Insecticide storage	none

Direction from well?		N/A		How many feet?		N/A	
FROM	TO	LITHOLOGIC LOG	FROM	TO	PLUGGING INTERVAL		

LITHOLOGIC LOG		PLUGGING INTERVALS	
FROM	TO	FROM	TO
0	3		
3	8		
8	72		
72	74		

Silty Top Soil
Clay
Sand + Gravel medium to Coarse
Clay

7 CONTRACTOR'S OR LANDOWNER'S CERTIFICATION: This water well was (1) constructed, (2) reconstructed, or (3) plugged under my jurisdiction and was completed on (mo/day/year) 1-29-97 and this record is true to the best of my knowledge and belief. Kansas Water Well Contractor's License No. 134 This Water Well Record was completed on (mo/day/yr) 2-17-97 under the business name of Rosencrantz Bemis Ent. Inc. by (signature) Alicia K. Colley