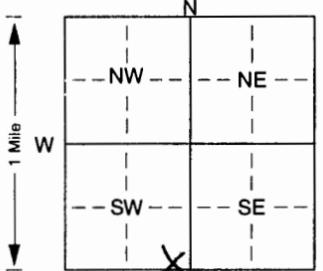


7 OWNER'S CERTIFICATION: This water well was constructed on 11/2/00(mo/day/year) under my jurisdiction and this record is true to the best of my knowledge and belief. This Water Well Record was completed on 2/8/01(mo/day/year) under the business name of Equus Beds Groundwater Management District No. 2. Kansas Water Well License No. not applicable.

(Signature and Title)

1) LOCATION OF WATER WELL:		Fraction	Section Number	Township Number	Range Number
County: <u>Reno</u>		<u>SE 1/4 SE 1/4 SW 1/4</u>	<u>2</u>	<u>T 24 S</u>	<u>R 4 E</u>
Distance and direction from nearest town or city street address of well if located within city? <u>350 of Burton 3 1/2 W N Side</u>					
2) WATER WELL OWNER: <u>GMP 2</u>					
RR#, St. Address, Box #			Board of Agriculture, Division of Water Resources		
City, State, ZIP Code: <u>313 Spruce</u> <u>Hastings KS 67056</u>			Application Number: <u>EB1A</u>		
3) LOCATE WELL'S LOCATION WITH		4) DEPTH OF COMPLETED WELL: <u>47</u> ft. ELEVATION:			
AN "X" IN SECTION BOX:		Depth(s) Groundwater Encountered 1. ft. 2. ft. 3. ft.			
		WELL'S STATIC WATER LEVEL <u>8</u> ft. below land surface measured on mo/day/yr <u>11-2-00</u>			
		Pump test data: Well water was ft. after hours pumping gpm			
		Est. Yield gpm: Well water was ft. after hours pumping gpm			
		Bore Hole Diameter. <u>6</u> in. to <u>4 1/2</u> ft., and in. to ft.			
		WELL WATER TO BE USED AS: 5 Public water supply 8 Air conditioning 11 Injection well			
		1 Domestic 3 Feedlot 6 Oil field water supply 9 Dewatering 12 Other (Specify below)			
		2 Irrigation 4 Industrial 7 Domestic (lawn & garden) 10 Monitoring well			
		Was a chemical/bacteriological sample submitted to Department? Yes. No. ; If yes, mo/day/yr sample was submitted			
		Water Well Disinfected? Yes No			
5) TYPE OF BLANK CASING USED:					
1 Steel		3 RMP (SR)		5 Wrought iron	
2 PVC		4 ABS		6 Asbestos-Cement	
				7 Fiberglass	
Blank casing diameter <u>8 1/2</u> in. to <u>40</u> ft., Dia in. to ft., Dia in. to ft.				CASING JOINTS: Glued. Clamped.	
Casing height above land surface <u>36</u> in., weight <u>Sec 40</u> lbs./ft. Wall thickness or gauge No.				Welded	
TYPE OF SCREEN OR PERFORATION MATERIAL:				Threaded.	
1 Steel		3 Stainless steel		5 Fiberglass	
2 Brass		4 Galvanized steel		6 Concrete tile	
				7 PVC	
				8 RMP (SR)	
				9 ABS	
				10 Asbestos-cement	
				11 Other (specify)	
				12 None used (open hole)	
SCREEN OR PERFORATION OPENINGS ARE:				8 Saw cut	
1 Continuous slot		3 Mill slot		9 Drilled holes	
2 Louvered shutter		4 Key punched		10 Other (specify) ft.	
SCREEN-PERFORATED INTERVALS: From <u>37</u> ft. to <u>47</u> ft., From ft. to ft.				11 None (open hole)	
				9 Drilled holes	
GRAVEL PACK INTERVALS: From <u>32</u> ft. to <u>47</u> ft., From ft. to ft.				10 Other (specify) ft.	
