


1 LOCATION OF WATER WELL: County: Reno	Fraction NW 1/4 SE 1/4 SW 1/4	Section Number 2	Township Number T 24 S	Range Number R 4 W
--	---	----------------------------	----------------------------------	------------------------------

Distance and direction from nearest town or city street address of well if located within city?

3 1/4 mi. W + 3 mi S of Burton, Ks.

2 WATER WELL OWNER: RR#, St. Address, Box # : City, State, ZIP Code	GARY L. Rimbey BURTON, KS 67020	Board of Agriculture, Division of Water Resources Application Number: T-83-182
---	--	--

3 LOCATE WELL'S LOCATION WITH AN "X" IN SECTION BOX:	4 DEPTH OF COMPLETED WELL: 40 ft. ELEVATION:
--	---

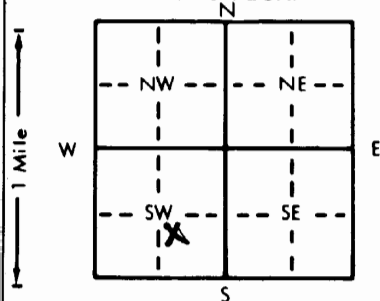

Depth(s) Groundwater Encountered 1.12 ft. 2. ft. 3. ft.	WELL'S STATIC WATER LEVEL 1.12 ft. below land surface measured on mo/day/yr 5-10-83
Pump test data: Well water was ... ft. after ... hours pumping ... gpm	Est. Yield 75-100 gpm: Well water was ... ft. after ... hours pumping ... gpm
Bore Hole Diameter 8 in. to 40 ft. and ... in. to ... ft.	WELL WATER TO BE USED AS:
1 Domestic 3 Feedlot 6 Oil field water supply 9 Dewatering 12 Other (Specify below)	5 Public water supply 8 Air conditioning 11 Injection well
2 Irrigation 4 Industrial 7 Lawn and garden only 10 Observation well	
Was a chemical/bacteriological sample submitted to Department? Yes ... No <input checked="" type="checkbox"/> If yes, mo/day/yr sample was submitted	Water Well Disinfected? Yes ... No <input checked="" type="checkbox"/>

5 TYPE OF BLANK CASING USED:	5 Wrought iron 8 Concrete tile CASING JOINTS: Glued <input checked="" type="checkbox"/> Clamped
1 Steel 3 RMP (SR) 6 Asbestos-Cement 9 Other (specify below) Welded	
2 PVC 4 ABS 7 Fiberglass Threaded	
Blank casing diameter 3 in. to 24 ft. Dia. 1.61 in. to ... ft. Dia. ... in. to ... ft.	
Casing height above land surface 1.2 in., weight 1.61 lbs./ft. Wall thickness or gauge No. 153	

TYPE OF SCREEN OR PERFORATION MATERIAL:	10 Asbestos-cement
1 Steel 3 Stainless steel 5 Fiberglass 8 RMP (SR) 11 Other (specify)	
2 Brass 4 Galvanized steel 6 Concrete tile 9 ABS 12 None used (open hole)	

SCREEN OR PERFORATION OPENINGS ARE:	5 Gauzed wrapped 8 Saw cut 11 None (open hole)
1 Continuous slot 3 Mill slot 6 Wire wrapped 9 Drilled holes	
2 Louvered shutter 4 Key punched 7 Torch cut 10 Other (specify)	

SCREEN-PERFORATED INTERVALS:	From 24 ft. to 39 ft. From ... ft. to ... ft.
GRAVEL PACK INTERVALS:	From 15 ft. to 39 ft. From ... ft. to ... ft.

6 GROUT MATERIAL:	1 Neat cement 2 Cement grout 3 Bentonite 4 Other
Grout Intervals: From 5 ft. to 15 ft. From ... ft. to ... ft.	

What is the nearest source of possible contamination:	10 Livestock pens 14 Abandoned water well
1 Septic tank 4 Lateral lines 7 Pit privy 11 Fuel storage 5 Oil well/Gas well	
2 Sewer lines 5 Cess pool 8 Sewage lagoon 12 Fertilizer storage 16 Other (specify below)	
3 Watertight sewer lines 6 Seepage pit 9 Feedyard 13 Insecticide storage	
Direction from well? South How many feet? 100 ft	

FROM	TO	LITHOLOGIC LOG	FROM	TO	LITHOLOGIC LOG
0	4	Top Soil			
4	8	Brown Clay			
8	12	Gray Sandy Clay			
12	20	Gray Clay & Med. Sand			
20	25	Med Red Sand			
25	40/7	Coarse Sand & Gravel			

7 CONTRACTOR'S OR LANDOWNER'S CERTIFICATION: This water well was (1) constructed, (2) reconstructed, or (3) plugged under my jurisdiction and was completed on (mo/day/year) 5-10-83 and this record is true to the best of my knowledge and belief. Kansas Water Well Contractor's License No. 138 This Water Well Record was completed on (mo/day/yr) 6-29-83 under the business name of Peterson Irrigation by (signature) Mike Peterson
INSTRUCTIONS: Use typewriter or ball point pen, PLEASE PRESS FIRMLY and PRINT clearly. Please fill in blanks, underline or circle the correct answers. Send top three copies to Kansas Department of Health and Environment, Division of Environment, Environmental Geology Section, Topeka, KS 66620. Send one to WATER WELL OWNER and retain one for your records.

DP

OFFICE USE ONLY

T

24

R

4

E

SEC.

2

NW 1/4 SE 1/4 SW 1/4