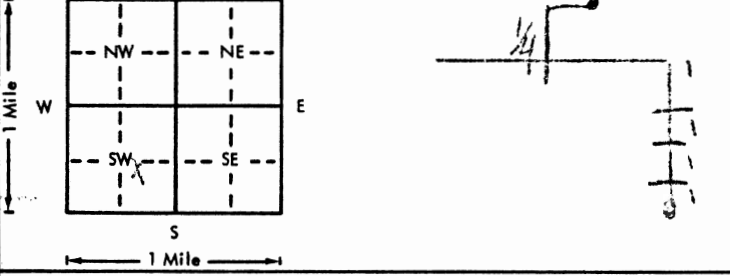


USE TYPEWRITER OR BALL
POINT PEN-PRESS FIRMLY,
PRINT CLEARLY.

WATER WELL RECORD
KSA 82a-1201-1215

Kansas Department of Health and
Environment-Division of Environment
(Water well Contractors)
Topeka, Kansas 66620

1. Location of well:		County <u>Leone</u>	Fraction <u>NW 1/4 SE 1/4 S 1/4</u>	Section number	Township number <u>T 24</u>	Range number <u>S 1 R 1</u>	E/W
2. Distance and direction from nearest town or city: <u>4 mi. south on</u> Street address of well location if in city: <u>Wahler-Haven rd. from 50th</u> <u>1/2 mi. west, rd. north, east</u>				3. Owner of well: <u>n-30 Inc.</u> R.R. or street: <u>200 North Main</u> City, state, zip code: <u>Topeka, Kansas</u>			
4. Locate with "X" in section below: Sketch map: <u>side</u>				6. Bore hole dia. <u>15</u> in. Completion date <u>6/2/67</u> Well depth <u>15</u> ft.			
				7. <input type="checkbox"/> Cable tool <input checked="" type="checkbox"/> Rotary <input type="checkbox"/> Driven <input type="checkbox"/> Dug <input type="checkbox"/> Hollow rod <input type="checkbox"/> Jetted <input type="checkbox"/> Bored <input type="checkbox"/> Reverse rotary			
				8. Use: <input type="checkbox"/> Domestic <input type="checkbox"/> Public supply <input type="checkbox"/> Industry <input type="checkbox"/> Irrigation <input type="checkbox"/> Air conditioning <input type="checkbox"/> Stock <input type="checkbox"/> Lawn <input type="checkbox"/> Oil field water <input type="checkbox"/> Other			

18. Elevation:		19. Remarks:					
Topography: <input type="checkbox"/> Hill <input type="checkbox"/> Slope <input type="checkbox"/> Upland <input type="checkbox"/> Valley		<u>15</u>					

RECEIVED

OCT 17 1979

DIVISION OF ENVIRONMENT

65-1-2-250

(Use a second sheet if needed)

RECEIVED

JUN 12 1979

Forward the white, blue and pink copies to the Department of Health and Environment
OF & EG SEC.

Form WWC-5