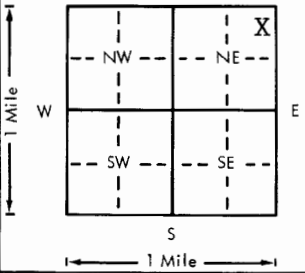


USE TYPEWRITER OR BALL
POINT PEN-PRESS FIRMLY,
PRINT CLEARLY.

WATER WELL RECORD
KSA 82a-1201-1215

Kansas Department of Health and
Environment-Division of Environment
(Water well Contractors)
Topeka, Kansas 66620

1. Location of well:		County RENO	Fraction 1/4 NE 1/4 NE 1/4	Section number 8	Township number T 24 S R 4W E/W	Range number
2. Distance and direction from nearest town or city: 5 miles N. of Haven, Ks., on Haven Rd. on the			3. Owner of well: Clark Miller R.R. or street: Burrtown, Kansas City, state, zip code:			
4. Locate with "X" in section below: 			Sketch map: W. side of the Rd. Haven, Kansas			
5. Type and color of material			From	To	6. Bore hole dia. 11 in. Completion date 7-28-78 Well depth 40 ft.	
Sandy Topsoil			0	4	7. <input checked="" type="checkbox"/> Cable tool <input checked="" type="checkbox"/> Rotary <input type="checkbox"/> Driven <input type="checkbox"/> Dug <input type="checkbox"/> Hollow rod <input type="checkbox"/> Jetted <input type="checkbox"/> Bored <input type="checkbox"/> Reverse rotary	
Brown Clay			4	10	8. Use: <input checked="" type="checkbox"/> Domestic <input type="checkbox"/> Public supply <input type="checkbox"/> Industry <input type="checkbox"/> Irrigation <input type="checkbox"/> Air conditioning <input type="checkbox"/> Stock <input type="checkbox"/> Lawn <input type="checkbox"/> Oil field water <input type="checkbox"/> Other	
Fine Sand			10	20	9. Casing: Material Styrene Height: Above or below Threaded <input type="checkbox"/> Welded <input checked="" type="checkbox"/> Surface 12 in. RMP <input checked="" type="checkbox"/> PVC Weight 12 lbs./ft. Dia. 5 in. to 40 ft. depth Wall Thickness: inches or Dia. 5 in. to 40 ft. depth gage No. 200	
Coarse Sand			20	40	10. Screen: Manufacturer's name Sunflower Plastic Type styrene Dia. 5" Slot 1/16" Length 15' Set between 25 ft. and 40 ft. ft. and ft. Gravel pack? yes Size range of material 1/4-1/8"	
					11. Static water level: 12 ft. below land surface Date 7-28-78	
					12. Pumping level below land surfaces: ft. after hrs. pumping g.p.m. ft. after hrs. pumping g.p.m. Estimated maximum yield g.p.m.	
					13. Water sample submitted: Yes No Date	
					14. Well head completion: 12 capped Pitless adapter 12 inches above grade	
					15. Well grouted? yes 1-2 Fine Sand Mix With: <input type="checkbox"/> Neat cement <input type="checkbox"/> Bentonite <input checked="" type="checkbox"/> Concrete Depth: From 40" ft. to 14 ft.	
					16. Nearest source of possible contamination: Septic ft. 50 Direction South Type Tank Well disinfected upon completion? <input checked="" type="checkbox"/> Yes <input type="checkbox"/> No	
					17. Pump: <input checked="" type="checkbox"/> Not installed Manufacturer's name Model number HP Volts Length of drop pipe ft. capacity g.p.m. Type: <input type="checkbox"/> Submersible <input type="checkbox"/> Turbine <input type="checkbox"/> Jet <input type="checkbox"/> Reciprocating <input type="checkbox"/> Centrifugal <input type="checkbox"/> Other	
18. Elevation:			19. Remarks: Flat Ground			
Topography: <input type="checkbox"/> Hill <input type="checkbox"/> Slope <input type="checkbox"/> Upland <input type="checkbox"/> Valley			20. Water well contractor's certification: This well was drilled under my jurisdiction and this report is true to the best of my knowledge and belief. Harp Well & Pump 236 Business name License No. Address Wichita, Kansas 67209 Signed M. Arnold Date 7-16-78 Authorized representative			

Forward the white, blue and pink copies to the Department of Health and Environment

Form WWC-5