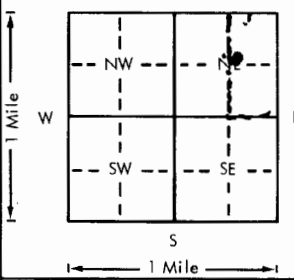
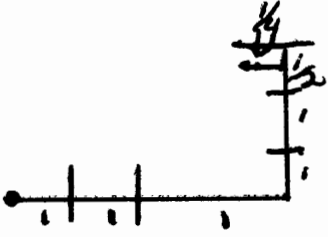


USE TYPEWRITER OR BALL
POINT PEN-PRESS FIRMLY,
PRINT CLEARLY.

WATER WELL RECORD
KSA 82a-1201-1215

Kansas Department of Health and
Environment-Division of Environment
(Water well Contractors)
Topeka, Kansas 66620

1. Location of well:	County <u>Reno</u> Hart	Fraction <u>SE 1/4 NE 1/4 NE 1/4</u>	Section number <u>13</u>	Township number <u>24S</u>	Range number <u>4W</u> E/W
2. Distance and direction from nearest town or city: <u>3 East of Haven</u>	3. Owner of well: <u>Don L. Hoskinson</u>				
Street address of well location if in city: <u>2 1/2 N 1/4 W in field</u>	R.R. or street: <u>R.R. 1</u>				
			City, state, zip code: <u>Burrton, Kansas 67020</u>		
4. Locate with "X" in section below:	Sketch map:		6. Bore hole dia. <u>26</u> in. Completion date <u>7/30/77</u> Well depth <u>45</u> ft.		
			7. <input type="checkbox"/> Cable tool <input type="checkbox"/> Rotary <input type="checkbox"/> Driven <input type="checkbox"/> Dug <input type="checkbox"/> Hollow rod <input type="checkbox"/> Jetted <input type="checkbox"/> Bored <input checked="" type="checkbox"/> Reverse rotary		
5. Type and color of material			8. Use: <input type="checkbox"/> Domestic <input type="checkbox"/> Public supply <input type="checkbox"/> Industry <input checked="" type="checkbox"/> Irrigation <input type="checkbox"/> Air conditioning <input type="checkbox"/> Stock <input type="checkbox"/> Lawn <input type="checkbox"/> Oil field water <input type="checkbox"/> Other		
			9. Casing: Material <u>Transite</u> Height: Above or below Threaded <input type="checkbox"/> Welded <input type="checkbox"/> Surface <input checked="" type="checkbox"/> <u>12</u> in. RMP <input type="checkbox"/> PVC <input type="checkbox"/> Weight <u>30</u> lbs./ft. Dia. <u>16</u> in. to <u>19</u> ft. depth Wall thickness: inches or Dia. <u>0</u> in. to <u>19</u> ft. depth gage No. <u>3/16</u>		
			10. Screen: Manufacturer's name <u>Johnson</u> Type <u>sawed</u> Dia. <u>16</u> Slot/gauze <u>3/16</u> Length <u>26</u> Set between <u>19</u> ft. and <u>45</u> ft. Gravel pack? <u>yes</u> Size range of material <u>1/8-1/4</u>		
			11. Static water level: <u>8</u> ft. below land surface Date <u>7/30/77</u>		
			12. Pumping level below land surfaces: <u>14</u> ft. after <u>1</u> hrs. pumping <u>700</u> g.p.m. <u>20</u> ft. after <u>2</u> hrs. pumping <u>700</u> g.p.m. Estimated maximum yield <u>700</u> g.p.m.		
			13. Water sample submitted: <u>Yes</u> <input checked="" type="checkbox"/> No <input type="checkbox"/> Date <u>7/30/77</u>		
			14. Well head completion: <u>8</u> inches above grade		
			15. Well grouted? <u>yes</u> With: <input type="checkbox"/> Neat cement <input type="checkbox"/> Bentonite <input checked="" type="checkbox"/> Concrete Depth: From <u>0</u> ft. to <u>10</u> ft.		
			16. Nearest source of possible contamination: ft. <u>none</u> Direction <u>none</u> Type <u>none</u> Well disinfected upon completion? <u>Yes</u> <input checked="" type="checkbox"/> No <input type="checkbox"/>		
			17. Pump: <u>Not installed</u> Manufacturer's name <u>Western Land Roller</u> Model number <u>1200</u> P <u>25</u> Volts <u>460</u> Length of drop pipe <u>30</u> ft. capacity <u>800</u> g.p.m. Type: <input type="checkbox"/> Submersible <input checked="" type="checkbox"/> Turbine <input type="checkbox"/> Jet <input type="checkbox"/> Reciprocating <input type="checkbox"/> Centrifugal <input type="checkbox"/> Other		
(Use a second sheet if needed)					
18. Elevation:	19. Remarks:		20. Water well contractor's certification: This well was drilled under my jurisdiction and this report is true to the best of my knowledge and belief. <u>Darling Drilling Co. 189</u> Business name <u>1231 W. 4th Hutchinson, KS</u> License No. <u>15-14</u> Address <u>Donald Darling</u> Signed <u>Donald Darling</u> Authorized representative		
Topography: <input type="checkbox"/> Hill <input checked="" type="checkbox"/> Slope <input type="checkbox"/> Upland <input type="checkbox"/> Valley					

Forward the white, blue and pink copies to the Department of Health and Environment

Form WWC-5