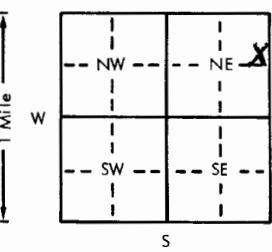
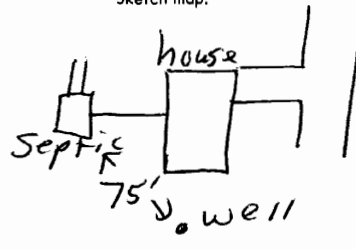


USE TYPEWRITER OR BALL
POINT PEN-PRESS FIRMLY,
PRINT CLEARLY.

WATER WELL RECORD
KSA 82a-1201-1215

Kansas Department of Health and
Environment-Division of Environment
(Water well Contractors)
Topeka, Kansas 66620

1. Location of well:		County Reno	Fraction SE 1/4 NE 1/4 NE 1/4	Section number 17	Township number T 24 S R 4 E	Range number 4
2. Distance and direction from nearest town or city: 5 mi. N. Haven Kansas				3. Owner of well: Great Plains Builders R.R. or street: Box 23 City, state, zip code: Haven Kansas 67543		
4. Locate with "X" in section below:		Sketch map:		6. Bore hole dia. 9 in. Completion date 3-24-78 Well depth 30 ft.		
				7. <input type="checkbox"/> Cable tool <input type="checkbox"/> Rotary <input type="checkbox"/> Driven <input checked="" type="checkbox"/> Dug <input type="checkbox"/> Hollow rod <input type="checkbox"/> Jetted <input checked="" type="checkbox"/> Bored <input type="checkbox"/> Reverse rotary		
5. Type and color of material				From	To	8. Use: <input checked="" type="checkbox"/> Domestic <input type="checkbox"/> Public supply <input type="checkbox"/> Industry <input type="checkbox"/> Irrigation <input type="checkbox"/> Air conditioning <input type="checkbox"/> Stock <input type="checkbox"/> Lawn <input type="checkbox"/> Oil field water <input type="checkbox"/> Other
brown sandy soil				0	3	9. Casing: Material Plas Height: above or below Threaded <input type="checkbox"/> Welded Galv Surface 12 in. RMP <input checked="" type="checkbox"/> PVC <input type="checkbox"/> Weight <input type="checkbox"/> lbs./ft. Dia. 6 in. to 30 ft. depth Wall Thickness: inches or Dia. <input type="checkbox"/> in. to <input type="checkbox"/> ft. depth gage No. 175
brown sandy clay				3	8	10. Screen: Manufacturer's name JPL Type RMP Dia. 6" Slot/gauze 1/8 hole Length 10' Set between 20 ft. and 30 ft. <input type="checkbox"/> ft. and <input type="checkbox"/> ft. Gravel pack? NO Size range of material <input type="checkbox"/>
fine sand				8	11	11. Static water level: 9 ft. below land surface Date 3-24-78 mo./day/yr.
fine & med. gravel				11	30	12. Pumping level below land surfaces: 9 1/2 ft. after 2 hrs. pumping 15 g.p.m. <input type="checkbox"/> ft. after <input type="checkbox"/> hrs. pumping <input type="checkbox"/> g.p.m. Estimated maximum yield 75 g.p.m.
						13. Water sample submitted: <input type="checkbox"/> Yes <input checked="" type="checkbox"/> No Date <input type="checkbox"/>
						14. Well head completion: <input checked="" type="checkbox"/> Pitless adapter 12 inches above grade
						15. Well grouted? yes With: <input checked="" type="checkbox"/> Neat cement <input type="checkbox"/> Bentonite <input type="checkbox"/> Concrete Depth: From 3 ft. to 10 ft.
						16. Nearest source of contamination: ft. 75 Direction NW Type Septic Well disinfected upon completion? <input checked="" type="checkbox"/> Yes <input type="checkbox"/> No
						17. Pump: Manufacturer's name STA-RITE Not installed Model number Ser 8 HP 1/2 Volts 230 Length of drop pipe 20 ft. capacity 12 g.p.m. Type: <input checked="" type="checkbox"/> Submersible <input type="checkbox"/> Turbine <input type="checkbox"/> Jet <input type="checkbox"/> Reciprocating <input type="checkbox"/> Centrifugal <input type="checkbox"/> Other
18. Elevation:				19. Remarks:		
Topography: <input type="checkbox"/> Hill <input type="checkbox"/> Slope <input type="checkbox"/> Upland <input checked="" type="checkbox"/> Valley				20. Water well contractor's certification: This well was drilled under my jurisdiction and this report is true to the best of my knowledge and belief. Price Water Well 193 Business name RR 3 Hutchinson License No. 5-10-78 Address John Davenport Date 5-10-78 Signed John Davenport Authorized representative		

Forward the white, blue and pink copies to the Department of Health and Environment

Form WWC-5

MI-1023