

1 LOCATION OF WATER WELL: Fraction NW 1/4 SE 1/4 SE 1/4 Section Number 20 Township Number T 24 S Range Number R 4 E
County: Reed

Distance and direction from nearest town or city street address of well if located within city?

3 1/2 No Haven

2 WATER WELL OWNER:

RR#, St. Address, Box #:


City, State, ZIP Code:

Dean Farbaugh
RR
HAUEN KS

Board of Agriculture, Division of Water Resources

Application Number:

3 LOCATE WELL'S LOCATION WITH AN "X" IN SECTION BOX:

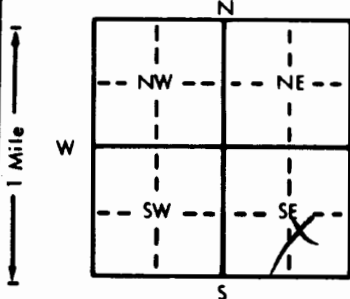

4 DEPTH OF COMPLETED WELL 33 ft. ELEVATION:

Depth(s) Groundwater Encountered 1. 10 ft. 2. 10 ft. 3. 12-13-85 ft.

WELL'S STATIC WATER LEVEL 10 ft. below land surface measured on mo/day/yr 12-13-85

Pump test data: Well water was 10 ft. after 20 hours pumping 30 gpm

Est. Yield 30 gpm: Well water was 10 ft. after 20 hours pumping 30 gpm

Bore Hole Diameter 1.1 in. to 33 ft. and 33 in. to 33 ft.

WELL WATER TO BE USED AS: 5 Public water supply 8 Air conditioning 11 Injection well

1 Domestic 3 Feedlot 6 Oil field water supply 9 Dewatering 12 Other (Specify below)

2 Irrigation 4 Industrial 7 Lawn and garden only 10 Observation well

Was a chemical/bacteriological sample submitted to Department? Yes No If yes, mo/day/yr sample was submitted

Water Well Disinfected? Yes X No

5 TYPE OF BLANK CASING USED:

1 Steel 3 RMP (SR) 5 Wrought iron 8 Concrete tile CASING JOINTS: Glued X Clamped

2 PVC 4 ABS 6 Asbestos-Cement 9 Other (specify below) Welded

Blank casing diameter 5 in. to 20 ft. Dia 1.59 in. to 50P-26 ft. Dia

Casing height above land surface 5 in. weight 1.59 lbs./ft. Wall thickness or gauge No. 50P-26

TYPE OF SCREEN OR PERFORATION MATERIAL:

1 Steel 3 Stainless steel 5 Fiberglass 7 PVC 10 Asbestos-cement

2 Brass 4 Galvanized steel 6 Concrete tile 8 RMP (SR) 11 Other (specify)

SCREEN OR PERFORATION OPENINGS ARE: 9 ABS 12 None used (open hole)

1 Continuous slot 3 Mill slot 5 Gauzed wrapped 8 Saw cut 11 None (open hole)

2 Louvered shutter 4 Key punched 6 Wire wrapped 9 Drilled holes

SCREEN-PERFORATED INTERVALS: From 20 ft. to 33 ft. From 20 ft. to 33 ft.

GRAVEL PACK INTERVALS: From 10 ft. to 33 ft. From 10 ft. to 33 ft.

From 10 ft. to 33 ft. From 10 ft. to 33 ft.

6 GROUT MATERIAL:

1 Neat cement 2 Cement grout 3 Bentonite 4 Other

Grout intervals: From 3 ft. to 10 ft. From 3 ft. to 10 ft.

What is the nearest source of possible contamination:

1 Septic tank 4 Lateral lines 7 Pit privy 10 Livestock pens 14 Abandoned water well

2 Sewer lines 5 Cess pool 8 Sewage lagoon 11 Fuel storage 15 Oil well/Gas well

3 Watertight sewer lines 6 Seepage pit 9 Feedyard 12 Fertilizer storage 16 Other (specify below)

Direction from well? SE

How many feet? 50

FROM	TO	LITHOLOGIC LOG	FROM	TO	LITHOLOGIC LOG
0	2	top soil			
2	9	clay			
9	17	fine sand			
17	18	clay			
18	33	med sand			

7 CONTRACTOR'S OR LANDOWNER'S CERTIFICATION: This water well was (1) constructed, (2) reconstructed, or (3) plugged under my jurisdiction and was completed on (mo/day/year) 12-13-85 and this record is true to the best of my knowledge and belief. Kansas

Water Well Contractor's License No. 318 This Water Well Record was completed on (mo/day/yr) 12-13-85

under the business name of Wagner Pully by (signature) Wagner

INSTRUCTIONS: Use typewriter or ball point pen. PLEASE PRESS FIRMLY and PRINT clearly. Please fill in blanks, underline or circle the correct answers. Send top three copies to Kansas Department of Health and Environment, Office of Oil Field and Environmental Geology, Regulation and Permitting Section, Topeka, Kansas 66620-7500, Telephone: 913-862-9360. Send one to WATER WELL OWNER and retain one for your records.