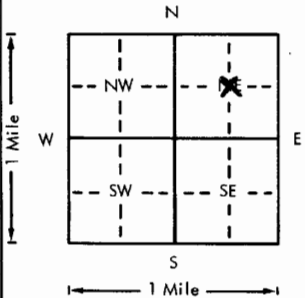


USE TYPEWRITER OR BALL  
POINT PEN-PRESS FIRMLY.  
PRINT CLEARLY.

WATER WELL RECORD  
KSA 82a-1201-1215

Kansas Department of Health and  
Environment-Division of Environment  
(Water well Contractors)  
Topeka, Kansas 66620

1. Location of well:		County <u>Reno</u>	Fraction <u>Center of</u> <u>1/4 1/4</u>	Section number <u>25</u>	Township number <u>T 24 S</u>	Range number <u>R 4 E</u> <u>(W)</u>
2. Distance and direction from nearest town or city: Street address of well location if in city: <u>3 m W. of Patterson</u> <u>on 4 E, 3 N of Haven</u>			3. Owner of well: <u>Craig Rife</u> R.R. or street: <u>Burrton, Kansas 67020</u> City, state, zip code:			
4. Locate with "X" in section below:		Sketch map:		6. Bore hole dia. <u>30</u> in. Completion date <u>2/18/77</u> Well depth <u>55</u> ft.		
		<u>open field</u>		7. <input type="checkbox"/> Cable tool <input type="checkbox"/> Rotary <input type="checkbox"/> Driven <input type="checkbox"/> Dug <input type="checkbox"/> Hollow rod <input type="checkbox"/> Jetted <input type="checkbox"/> Bored <input checked="" type="checkbox"/> Reverse rotary		
5. Type and color of material		From		To		8. Use: <input type="checkbox"/> Domestic <input type="checkbox"/> Public supply <input type="checkbox"/> Industry <input checked="" type="checkbox"/> Irrigation <input type="checkbox"/> Air conditioning <input type="checkbox"/> Stock <input type="checkbox"/> Lawn <input type="checkbox"/> Oil field water <input type="checkbox"/> Other
<u>Topsoil</u>		<u>0</u>		<u>1</u>		9. Casing: Material <u>C-Ash</u> Height: <u>Above</u> or below Threaded <input type="checkbox"/> Welded <input type="checkbox"/> Surface <u>12</u> in. RMP <input type="checkbox"/> PVC <input type="checkbox"/> Weight <input type="checkbox"/> lbs./ft. Dia. <u>1 1/2</u> in. to <u>55</u> ft. depth Wall Thickness: inches or Dia. <input type="checkbox"/> in. to <input type="checkbox"/> ft. depth gage No. <u>314</u>
<u>Fine Sand &amp; Clay</u>		<u>1</u>		<u>15</u>		10. Screen: Manufacturer's name <u>Johnson</u> Type <u>Cem-Ash</u> Dia. <u>1 1/2</u> " Slot/gauze <u>44</u> Length <u>26</u> Set between <u>29</u> ft. and <u>55</u> ft. Gravel pack? <input checked="" type="checkbox"/> Size range of material <u>3/8</u>
<u>Gray Clay</u>		<u>15</u>		<u>27</u>		11. Static water level: <u>20</u> ft. below land surface Date <u>2/18/77</u>
<u>Med. Good Gravel</u>		<u>27</u>		<u>55</u>		12. Pumping level below land surfaces: <u>25</u> ft. after <u>1</u> hrs. pumping <u>700</u> g.p.m. ft. after <u>   </u> hrs. pumping <u>   </u> g.p.m. Estimated maximum yield <u>800</u> g.p.m.
<u>Clay</u>		<u>55</u>		<u>↓</u>		13. Water sample submitted: <u>   </u> mo./day/yr. <input type="checkbox"/> Yes <input checked="" type="checkbox"/> No Date <u>   </u>
						14. Well head completion: <input type="checkbox"/> Pitless adapter <u>12</u> inches above grade
						15. Well grouted? <input checked="" type="checkbox"/> With: <input type="checkbox"/> Neat cement <input type="checkbox"/> Bentonite <input checked="" type="checkbox"/> Concrete Depth: From <u>0</u> ft. to <u>10</u> ft.
						16. Nearest source of possible contamination: ft. <u>1600</u> Direction <u>E</u> Type <u>Dom.</u> Well disinfected upon completion? <input type="checkbox"/> Yes <input checked="" type="checkbox"/> No
						17. Pump: <u>   </u> Not installed Manufacturer's name <u>Peerless</u> Model number <u>6805</u> HP <u>40</u> Volts <u>   </u> Length of drop pipe <u>40</u> ft. capacity <u>750</u> g.p.m. Type: <input type="checkbox"/> Submersible <input checked="" type="checkbox"/> Turbine <input type="checkbox"/> Jet <input type="checkbox"/> Reciprocating <input type="checkbox"/> Centrifugal <input type="checkbox"/> Other
18. Elevation:		19. Remarks:		20. Water well contractor's certification: This well was drilled under my jurisdiction and this report is true to the best of my knowledge and belief. <u>Weninger Irrigation</u> Business name <u>Maize</u> License No. <u>   </u> Address <u>   </u> Signed <u>A. Weninger</u> Date <u>   </u> Authorized representative		

Forward the white, blue and pink copies to the Department of Health and Environment

Form WWC-5