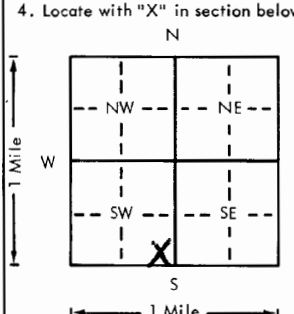


USE TYPEWRITER OR BALL  
POINT PEN-PRESS FIRMLY,  
PRINT CLEARLY.

WATER WELL RECORD  
KSA 82a-1201-1215

Kansas Department of Health and  
Environment-Division of Environment  
(Water well Contractors)  
Topeka, Kansas 66620

|   |  |                    |   |  |                               |                           |
|---|--|--------------------|---|--|-------------------------------|---------------------------|
| 1. Location of well:  |  | County <u>Reno</u> | Fraction <u>SE 1/4 SE 1/4 SW 1/4</u>  | Section number <u>35</u>   | Township number <u>T 24 S</u> | Range number <u>R 4 E</u> |
| 2. Distance and direction from nearest town or city:<br><u>1 N 2 1/2 E Haven Kan.</u> |  |                    | 3. Owner of well: <u>Jim Schmidt</u><br>R.R. or street: <u>RR 2</u><br>City, state, zip code: <u>Haven Kan. 67543</u> |  |                               |                           |
| 4. Locate with "X" in section below:  |  | Sketch map:        |   | 6. Bore hole dia. <u>6</u> in. Completion date <u>5-16-79</u><br>Well depth <u>45</u> ft.  |                               |                           |
|       |  |                    |   | 7. <input type="checkbox"/> Cable tool <input type="checkbox"/> Rotary <input type="checkbox"/> Driven <input checked="" type="checkbox"/> Dug<br><input type="checkbox"/> Hollow rod <input type="checkbox"/> Jetted <input checked="" type="checkbox"/> Bored <input type="checkbox"/> Reverse rotary  |                               |                           |
| 5. Type and color of material   |  | From               | To  | 8. Use: <input checked="" type="checkbox"/> Domestic <input type="checkbox"/> Public supply <input type="checkbox"/> Industry<br><input type="checkbox"/> Irrigation <input type="checkbox"/> Air conditioning <input type="checkbox"/> Stock<br><input type="checkbox"/> Lawn <input type="checkbox"/> Oil field water <input type="checkbox"/> Other   |                               |                           |
| <u>brown sandy soil</u>   |  | <u>0</u>           | <u>2</u>  | 9. Casing: Material <u>Plas</u> Height: <u>12</u> in. or below<br>Threaded <input type="checkbox"/> Welded <input checked="" type="checkbox"/> Surface <u>12</u> in.<br>RMP <input checked="" type="checkbox"/> PVC <input type="checkbox"/> Weight <u>15</u> lbs./ft.<br>Dia. <u>6</u> in. to <u>45</u> ft. depth Wall Thickness: inches or<br>Dia. <u>11</u> in. to <u>17</u> ft. depth gage No. <u>1175</u>                     |                               |                           |
| <u>brown sandy clay</u>   |  | <u>2</u>           | <u>9</u>  | 10. Screen: Manufacturer's name <u>RL</u><br>Type <u>RMP</u> Dia. <u>6</u> "<br>Slot/gauze <u>1/8 hole</u> Length <u>10</u> '<br>Set between <u>35</u> ft. and <u>45</u> ft.<br>ft. and ft.<br>Gravel pack? <u>no</u> Size range of material   |                               |                           |
| <u>fine sand</u>  |  | <u>9</u>           | <u>17</u>   | 11. Static water level: <u>18</u> ft. below land surface Date <u>5-16-79</u> mo./day/yr.   |                               |                           |
| <u>fine gravel</u>  |  | <u>17</u>          | <u>30</u>   | 12. Pumping level below land surfaces:<br><u>19</u> ft. after <u>1</u> hrs. pumping <u>15</u> g.p.m.<br>ft. after hrs. pumping g.p.m.<br>Estimated maximum yield <u>50</u> g.p.m.  |                               |                           |
| <u>medium gravel</u>  |  | <u>30</u>          | <u>45</u>   | 13. Water sample submitted: <u>no</u> mo./day/yr.<br>Yes <input type="checkbox"/> No <input checked="" type="checkbox"/> Date  |                               |                           |
|   |  |                    |   | 14. Well head completion:<br><input checked="" type="checkbox"/> Pitless adapter <u>12</u> inches above grade  |                               |                           |
|   |  |                    |   | 15. Well grouted? <u>yes</u><br>With: <input checked="" type="checkbox"/> Neat cement <input type="checkbox"/> Bentonite <input type="checkbox"/> Concrete<br>Depth: From <u>3</u> ft. to <u>13</u> ft.  |                               |                           |
|   |  |                    |   | 16. Nearest source of possible contamination: <u>Septic</u><br>ft. <u>60</u> Direction <u>NE</u> Type <u>Septic</u><br>Well disinfected upon completion? <input checked="" type="checkbox"/> Yes <input type="checkbox"/> No   |                               |                           |
|   |  |                    |   | 17. Pump: Not installed<br>Manufacturer's name <u>STA RITE</u><br>Model number <u>828</u> HP <u>1/2</u> Volts <u>230</u><br>Length of drop pipe <u>30</u> ft. capacity <u>12</u> g.p.m.<br>Type:<br><input checked="" type="checkbox"/> Submersible <input type="checkbox"/> Turbine<br><input type="checkbox"/> Jet <input type="checkbox"/> Reciprocating<br><input type="checkbox"/> Centrifugal <input type="checkbox"/> Other |                               |                           |
| 18. Elevation:  |  | 19. Remarks:       |   | 20. Water well contractor's certification:<br>This well was drilled under my jurisdiction and this report is true to the best of my knowledge and belief.<br><u>Price Water Well 193</u><br>Business name <u>RR 3 Hutchinson</u> License No. <u>1/4 1/4 1/4</u><br>Address <u>RR 3 Hutchinson</u><br>Signed <u>J. Lawrence</u> Date <u>6-15-79</u><br>Authorized representative  |                               |                           |

Forward the white, blue and pink copies to the Department of Health and Environment

Form WWC-5