


1 LOCATION OF WATER WELL: Fraction NW 1/4 NE 1/4 SE 1/4 Section Number 7 Township Number T 24 S Range Number R 40 EW

Distance and direction from nearest town or city street address of well if located within city?
 East U.S. Highway 50, Syracuse, Ks. MW2

2 WATER WELL OWNER: City of Syracuse
 RR#, St. Address, Box #: Box 148 Board of Agriculture, Division of Water Resources
 City, State, ZIP Code: Syracuse, Ks. 67878 Application Number:

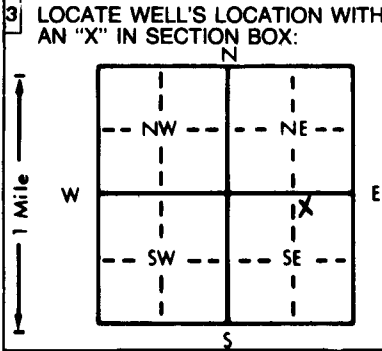

4 DEPTH OF COMPLETED WELL... 21.7 ft. ELEVATION: ...
 Depth(s) Groundwater Encountered 1... 15 ft. 2... ft. 3... ft.
 WELL'S STATIC WATER LEVEL... 15.60 ft. below land surface measured on mo/day/yr... 10-29-91
 Pump test data: Well water was ... ft. after ... hours pumping ... gpm
 Est. Yield ... gpm: Well water was ... ft. after ... hours pumping ... gpm
 Bore Hole Diameter: 7.5/8 in. to 21.71 ft., and ... in. to ... ft.
 WELL WATER TO BE USED AS: 5 Public water supply 8 Air conditioning 11 Injection well
 1 Domestic 3 Feedlot 6 Oil field water supply 9 Dewatering 12 Other (Specify below)
 2 Irrigation 4 Industrial 7 Lawn and garden only 10 Monitoring well
 Was a chemical/bacteriological sample submitted to Department? Yes... No... X...; If yes, mo/day/yr sample was submitted
 Water Well Disinfected? Yes No X

5 TYPE OF BLANK CASING USED: 5 Wrought iron 8 Concrete tile CASING JOINTS: Glued... Clamped...
 1 Steel 3 RMP (SR) 6 Asbestos-Cement 9 Other (specify below) Welded...
 2 PVC 4 ABS 7 Fiberglass Threaded... X
 Blank casing diameter... 2 in. to 11.7 ft., Dia... in. to ... ft., Dia... in. to ... ft.
 Casing height above land surface... 24 in., weight... lbs./ft. Wall thickness or gauge No. Schedule 40
 TYPE OF SCREEN OR PERFORATION MATERIAL: 7 PVC 10 Asbestos-cement
 1 Steel 3 Stainless steel 5 Fiberglass 8 RMP (SR) 11 Other (specify) ...
 2 Brass 4 Galvanized steel 6 Concrete tile 9 ABS 12 None used (open hole)
 SCREEN OR PERFORATION OPENINGS ARE: 5 Gauzed wrapped 8 Saw cut 11 None (open hole)
 1 Continuous slot 3 Mill slot 6 Wire wrapped 9 Drilled holes
 2 Louvered shutter 4 Key punched 7 Torch cut 10 Other (specify) ...
 SCREEN-PERFORATED INTERVALS: From... 11.7 ft. to 21.7 ft., From... ft. to ... ft.
 GRAVEL PACK INTERVALS: From... 10 ft. to 21.7 ft., From... ft. to ... ft.

6 GROUT MATERIAL: 1 Neat cement 2 Cement grout 3 Bentonite 4 Other ...
 Grout Intervals: From... 0 ft. to 1 (cement) ft., From... 1 ft. to 10 (bent) ft., From... ft. to ... ft.
 What is the nearest source of possible contamination:
 1 Septic tank 4 Lateral lines 7 Pit privy 10 Livestock pens 14 Abandoned water well
 2 Sewer lines 5 Cess pool 8 Sewage lagoon 11 Fuel storage 15 Oil well/Gas well
 3 Watertight sewer lines 6 Seepage pit 9 Feedyard 12 Fertilizer storage 16 Other (specify below)
 13 Insecticide storage
 Direction from well? North How many feet? 120

| FROM | TO | LITHOLOGIC LOG | FROM | TO | PLUGGING INTERVALS |
|------|------|----------------------------------------------|------|----|-------------------------|
| 0 | 8 | Clay, dark brown | | | |
| | | | | | KDHE Site Tag #00049555 |
| 8 | 10 | Sand, brown, fine | | | |
| | | | | | Above ground well cover |
| 10 | 14.5 | Sand, yellow, fine to coarse | | | |
| 14.5 | 21.5 | Sand, grey to black, coarse to medium gravel | | | |
| 21.5 | 21.7 | Shale, grey | | | |

7 CONTRACTOR'S OR LANDOWNER'S CERTIFICATION: This water well was 1) constructed (2) reconstructed, or (3) plugged under my jurisdiction and was completed on (mo/day/year) 10-18-91 and this record is true to the best of my knowledge and belief. Kansas Water Well Contractor's License No. 527 This Water Well Record was completed on (mo/day/yr) 10-31-91 under the business name of GeoCore Services, Inc. by (signature) Dan Bell