

SIRACUSE WEST

USE TYPEWRITER OR BALL POINT PEN-PRESS FIRMLY, PRINT CLEARLY.

T R EW sec 1/4 1/4 1/4 No.

WATER WELL RECORD KSA 82a-1201-1215

Kansas State Dept. Of Health (Water Well Contractors) Forbes-Bldg. 740 Topeka, Kansas 66620

DRC

1 Location of well: County Hamilton Township name Fraction SW 1/4, NW 1/4, SE 1/4 Section number 7 Town number T 24 S Range number R 40 W

Distance and direction from nearest town or city: 1/4 mile east of Syracuse Street address of well location if in city: 3 Owner of well: Dave Schwieterman Syracuse, KS Address:

Locate with "X" in section below: Sketch map: 4 Well depth: 60 ft. Date of completion 4-22-75 Well diameter 26 in.

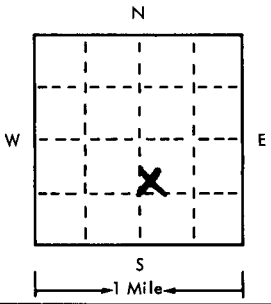


Table with 3 columns: 2 Type and color of material, From, To. Entry: See Attached, BROOK 95'

5 Cable tool Rotary Driven Dug Hollow rod Jetted Bored Reverse rotary 6 Use: Domestic Public supply Industry Irrigation Air conditioning Commercial Test well 7 Casing: Material Steel Height: above below Threading Welded Surface Diam. 36 lbs./ft. 16 in. to 60 ft. depth Drive shoe? Yes No

8 Screen: Manufacturer Johnson Type Continuous Dia. 16 Slot/gauze 150 Length 20 Set between 37 ft. and 57 ft. Fittings: Gravel pack Yes No Size range of material 1/2 to 1/8

9 Static water level: 14 ft. below land surface Date 4-22-75

10 Pumping level below land surfaces: not test pumped

11 Water sample submitted: Yes No Date

12 Well head completion: 12 Pitless adapter Inches above grade

13 Well grouted? Yes No Neat cement Bentonite Depth: From 0 ft. to 10 ft.

14 Nearest source of possible contamination: none observed

15 Pump: Not installed Manufacturer's name Johnston Model number 12DC HP Volts Length of drop pipe 45 ft. capacity g.m.p. Type: Submersible Turbine Jet Reciprocating Centrifugal Other

16 Remarks: elevation 3230 (TLPO) Topography: Flat

17 Water well contractor's certification: This well was drilled under my jurisdiction and this report is true to the best of my knowledge and belief. Henkle Drilling & Supply 145 Business name License No. Address Box 639 Garden City KS Signed Janek Henkle Date 5/15/75 Authorized representative

DRILLERS TEST LOG

CUSTOMERS NAME Dave Schwietzman DATE 2-19-75
STREET ADDRESS _____ TEST # 1
CITY & STATE Syracuse, Kansas DRILLER Livingston
COUNTY Hamilton QUARTER SE SECTION 7 TOWNSHIP 24 RANGE 40

LOCATION 1300 Ft. South of the NW corner of the SE4

WELL LOCATION

%	DRILLED FOOTAGE		Description of Strata	Static Water Level Proposed Well Depth
	from	Pay to		
	0	2	Top soil	
	2	7	Brown clay	
90	7	57	Sand fine to med. small to large gravel. Cobblestones	
	57	90	Weathered shale and hard ledges	
	90	95	Limestone and shale, Hard	
	95	110	Weathered shale	
	110	130	Shale, limestone ledges, few Dakota st.	
	130	170	Limestone, non-lime	
Total Depth of Well 60 Ft.				
Set up north; Dig pit on the East				