


1 LOCATION OF WATER WELL: County: Hamilton Fraction: NE 1/4 NE 1/4 SW 1/4 Section Number: 7 Township Number: T 24 S Range Number: R 40 E

Distance and direction from nearest town or city street address of well if located within city? 200 South Main, Syracuse, Ks.

2 WATER WELL OWNER: Syracuse Cooperative Exchange RR#, St. Address, Box #: P.O. Box 946 City, State, ZIP Code: Syracuse, Ks 67878 Board of Agriculture, Division of Water Resources Application Number:

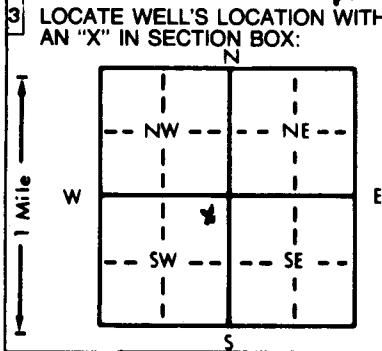

3 LOCATE WELL'S LOCATION WITH AN 'X' IN SECTION BOX: 4 DEPTH OF COMPLETED WELL: 25.0 ft. ELEVATION: Depth(s) Groundwater Encountered: 1. 19 ft. 2. ft. 3. ft. WELL'S STATIC WATER LEVEL: 17.91 ft. below land surface measured on mo/day/yr 06/10/92

5 TYPE OF BLANK CASING USED: 1 Steel 3 RMP (SR) 5 Wrought iron 8 Concrete tile CASING JOINTS: Glued Clamped 2 PVC 4 ABS 6 Asbestos-Cement 9 Other (specify below) Welded 7 Fiberglass Threaded

TYPE OF SCREEN OR PERFORATION MATERIAL: 1 Steel 3 Stainless steel 5 Fiberglass 8 RMP (SR) 10 Asbestos-cement 2 Brass 4 Galvanized steel 6 Concrete tile 9 ABS 11 Other (specify) 12 None used (open hole) SCREEN OR PERFORATION OPENINGS ARE: 1 Continuous slot 3 Mill slot 5 Gauzed wrapped 8 Saw cut 11 None (open hole) 2 Louvered shutter 4 Key punched 6 Wire wrapped 9 Drilled holes 7 Torch cut 10 Other (specify)

6 GROUT MATERIAL: 1 Neat cement 2 Cement grout 3 Bentonite 4 Other Grout Intervals: From 5 ft. to 13 ft. From ft. to ft. to ft. to ft. What is the nearest source of possible contamination: 1 Septic tank 4 Lateral lines 7 Pit privy 10 Livestock pens 14 Abandoned water well 2 Sewer lines 5 Cess pool 8 Sewage lagoon 11 Fuel storage 15 Oil well/Gas well 3 Watertight sewer lines 6 Seepage pit 9 Feedyard 12 Fertilizer storage 16 Other (specify below) 13 Insecticide storage Direction from well? NW How many feet? ~15'

Table with columns: FROM, TO, LITHOLOGIC LOG, FROM, TO, PLUGGING INTERVALS. Log entries include ASPHALT PAVING, CLAY: DK OLBR TO DK BR, SAND: BROWN, FINE GR., CLAY: DK BR, LEAN, SAND: BROWN: FINE TO COARSE GP, SAND + GRAVEL; BROWN w/ CLAY.

7 CONTRACTOR'S OR LANDOWNER'S CERTIFICATION: This water well was (1) constructed, (2) reconstructed, or (3) plugged under my jurisdiction and was completed on (mo/day/year) 06/10/92 and this record is true to the best of my knowledge and belief. Kansas Water Well Contractor's License No. 531 This Water Well Record was completed on (mo/day/yr) 06/22/92 under the business name of Geotechnical Services Inc by (signature) Sandra Heidi-Wrance

INSTRUCTIONS: Use typewriter or ball point pen. PLEASE PRESS FIRMLY and PRINT clearly. Please fill in blanks, underline or circle the correct answers. Send top three copies to Kansas Department of Health and Environment, Bureau of Water, Topeka, Kansas 66620-0001. Telephone: 913-296-5545. Send one to WATER WELL OWNER and retain one for your records.