


1 LOCATION OF WATER WELL: County: HAMILTON Fraction: NE 1/4 1/6 1/4 SW 1/4 Section Number: 7 Township Number: T 24 S Range Number: R 40 E(N)

Distance and direction from nearest town or city street address of well if located within city?
200 South Main, Syracuse, Ks.

2 WATER WELL OWNER: Syracuse Cooperative Exchange
 RR#, St. Address, Box #: P.O. Box 946 Board of Agriculture, Division of Water Resources
 City, State, ZIP Code: Syracuse, Ks. 67878 Application Number:

3 LOCATE WELL'S LOCATION WITH AN "X" IN SECTION BOX:

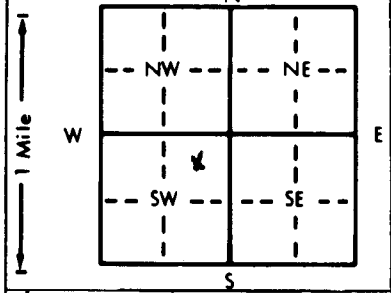

4 DEPTH OF COMPLETED WELL: 25.0 ft. ELEVATION:
 Depth(s) Groundwater Encountered 1. 18 ft. 2. _____ ft. 3. _____ ft.
 WELL'S STATIC WATER LEVEL: 16.58 ft. below land surface measured on 06/10/92
 Pump test data: Well water was _____ ft. after _____ hours pumping _____ gpm
 Est. Yield _____ gpm: Well water was _____ ft. after _____ hours pumping _____ gpm
 Bore Hole Diameter: 8.25 in. to 25.0 ft., and _____ in. to _____ ft.

WELL WATER TO BE USED AS: 5 Public water supply 8 Air conditioning 11 Injection well
 1 Domestic 3 Feedlot 6 Oil field water supply 9 Dewatering 12 Other (Specify below)
 2 Irrigation 4 Industrial 7 Lawn and garden only 0 Monitoring well #2
 Was a chemical/bacteriological sample submitted to Department? Yes _____ No If yes, mo/day/yr sample was submitted
 Water Well Disinfected? Yes _____ No

5 TYPE OF CASING USED: 1 Steel 3 RMP (SR) 5 Wrought iron 8 Concrete tile CASING JOINTS: Glued _____ Clamped _____
 2 PVC 4 ABS 6 Asbestos-Cement 9 Other (specify below) Welded _____
 7 Fiberglass Threaded

Blank casing diameter: 2 in. to 18 in. Dia _____ in. to _____ ft., Dia _____ in. to _____ ft.
 Casing height above land surface: + 36 in., weight _____ lbs./ft. Wall thickness or gauge No. SCH 40

TYPE OF SCREEN OR PERFORATION MATERIAL: 7 PVC 10 Asbestos-cement
 1 Steel 3 Stainless steel 5 Fiberglass 8 RMP (SR) 11 Other (specify) _____
 2 Brass 4 Galvanized steel 6 Concrete tile 9 ABS 12 None used (open hole)

SCREEN OR PERFORATION OPENINGS ARE: 1 Continuous slot 3 Mill slot 5 Gauzed wrapped 8 Saw cut 11 None (open hole)
 2 Louvered shutter 4 Key punched 6 Wire wrapped 9 Drilled holes
 7 Torch cut 10 Other (specify) _____

SCREEN-PERFORATED INTERVALS: From 15 ft. to 25 ft. From _____ ft. to _____ ft.
 From _____ ft. to _____ ft. From _____ ft. to _____ ft.
 GRAVEL PACK INTERVALS: From 12 ft. to 25 ft. From _____ ft. to _____ ft.
 From _____ ft. to _____ ft. From _____ ft. to _____ ft.

6 GROUT MATERIAL: 1 Neat cement 2 Cement grout 3 Bentonite 4 Other _____
 Grout Intervals: From 12 ft. to 0 ft. From _____ ft. to _____ ft. From _____ ft. to _____ ft.

What is the nearest source of possible contamination: 1 Septic tank 4 Lateral lines 7 Pit privy 10 Livestock pens 14 Abandoned water well
 2 Sewer lines 5 Cess pool 8 Sewage lagoon 11 Fuel storage 15 Oil well/Gas well
 3 Watertight sewer lines 6 Seepage pit 9 Feedyard 12 Fertilizer storage 16 Other (specify below)
 13 Insecticide storage
 Direction from well? NW How many feet? ~105'

FROM	TO	LITHOLOGIC LOG	FROM	TO	PLUGGING INTERVALS
0	.5	SAND & GRAVEL PAVING			
.5	3.0	SILT; DK BR, SANDY, CLAYEY W/ Pebbles			
3.0	7.0	CLAY; GR BR			
7.0	12.0	SAND; GR BR TO BR, FINE GR			
12.0	13.0	CLAY; GR BR			
13.0	16.0	SAND; BROWN, FINE TO MED GR WITH Pebbles @ 16.0			
16.0	25.0	SAND & GRAVEL; BROWN, SOME CLAY			

7 CONTRACTOR'S OR LANDOWNER'S CERTIFICATION: This water well was constructed, (2) reconstructed, or (3) plugged under my jurisdiction and was completed on (mo/day/year) 06/10/92 and this record is true to the best of my knowledge and belief. Kansas
 Water Well Contractor's License No. 531 This Water Well Record was completed on (mo/day/yr) 06/22/92
 under the business name of Hydrotechnical Services Inc by (signature) Daniel Glende Wallace

INSTRUCTIONS: Use typewriter or ball point pen. PLEASE PRESS FIRMLY and PRINT clearly. Please fill in blanks, underline or circle the correct answers. Send top three copies to Kansas Department of Health and Environment, Bureau of Water, Topeka, Kansas 66620-0001. Telephone: 913-296-5545. Send one to WATER WELL OWNER and retain one for your records.