


1 LOCATION OF WATER WELL: County: Hamilton Fraction: NE 1/4 SW 1/4 SW 1/4 Section Number: 8 Township Number: T 24S S Range Number: R 40W E/W

Distance and direction from nearest town or city street address of well if located within city?
E side of Syracuse Ave

2 WATER WELL OWNER: Gene Weckert
 RR#, St. Address, Box #: Syracuse KS 67878
 City, State, ZIP Code: Syracuse KS 67878
 Board of Agriculture, Division of Water Resources
 Application Number:

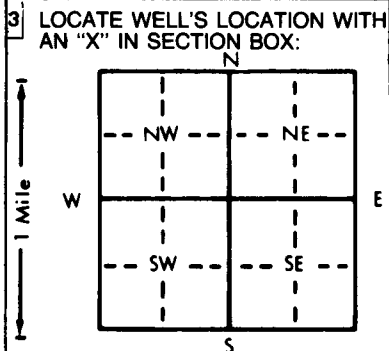

4 DEPTH OF COMPLETED WELL: 350 ft. ELEVATION:
 Depth(s) Groundwater Encountered: 260 ft. 2. 999 ft. 3. 999 ft.
 WELL'S STATIC WATER LEVEL: 999 ft. below land surface measured on mo/day/yr
 Pump test data: Well water was _____ ft. after _____ hours pumping _____ gpm
 Est. Yield 70 gpm: Well water was _____ ft. after _____ hours pumping _____ gpm
 Bore Hole Diameter: 7 7/8 in. to 350 ft., and _____ in. to _____ ft.
 WELL WATER TO BE USED AS:
 1 Domestic 3 Feedlot 6 Oil field water supply 9 Dewatering 11 Injection well
 2 Irrigation 4 Industrial 7 Lawn and garden only 10 Monitoring well
 Was a chemical/bacteriological sample submitted to Department? Yes _____ No _____; If yes, mo/day/yr sample was submitted _____
 Water Well Disinfected? Yes No _____

5 TYPE OF BLANK CASING USED:
 1 Steel 3 RMP (SR) 5 Wrought iron 8 Concrete tile CASING JOINTS: Glued Clamped
 2 PVC 4 ABS 6 Asbestos-Cement 9 Other (specify below) Welded
 _____ 7 Fiberglass _____ _____ Threaded
 Blank casing diameter: 5 in. to 250 ft., Dia _____ in. to _____ ft., Dia _____ in. to _____ ft.
 Casing height above land surface: 12 in., weight Sch 40 lbs./ft. Wall thickness or gauge No. _____
 TYPE OF SCREEN OR PERFORATION MATERIAL:
 1 Steel 3 Stainless steel 5 Fiberglass 8 RMP (SR) 10 Asbestos-cement
 2 Brass 4 Galvanized steel 6 Concrete tile 9 ABS 11 Other (specify) _____
 12 None used (open hole)
 SCREEN OR PERFORATION OPENINGS ARE:
 1 Continuous slot 3 Mill slot 5 Gauzed wrapped 8 Saw cut 11 None (open hole)
 2 Louvered shutter 4 Key punched 6 Wire wrapped 9 Drilled holes
 7 Torch cut 10 Other (specify) _____
 SCREEN-PERFORATED INTERVALS: From 250 ft. to 350 ft., From _____ ft. to _____ ft.
 From _____ ft. to _____ ft., From _____ ft. to _____ ft.
 GRAVEL PACK INTERVALS: From 20 ft. to 350 ft., From _____ ft. to _____ ft.
 From _____ ft. to _____ ft., From _____ ft. to _____ ft.

6 GROUT MATERIAL: 1 Neat cement 2 Cement grout 3 Bentonite 4 Other _____
 Grout intervals: From _____ ft. to _____ ft., From _____ ft. to _____ ft., From _____ ft. to _____ ft.
 What is the nearest source of possible contamination:
 1 Septic tank 4 Lateral line 7 Pit privy 10 Livestock pens 14 Abandoned water well
 2 Sewer lines 5 Cess pool 8 Sewage lagoon 11 Fuel storage 15 Oil well/Gas well
 3 Watertight sewer lines 6 Seepage pit 9 Feedyard 12 Fertilizer storage 16 Other (specify below) _____
 13 Insecticide storage
 Direction from well? _____ How many feet? 150

FROM	TO	LITHOLOGIC LOG	FROM	TO	PLUGGING INTERVALS
		<u>28' 8 7/8 steel surface casing cemented in</u>			
<u>0</u>	<u>23</u>	<u>Overburden</u>			
<u>23</u>	<u>26</u>	<u>Shale</u>			
<u>26</u>	<u>250</u>	<u>Blue Shale</u>			
<u>250</u>	<u>350</u>	<u>Blue Shale w/ Dakota Sand Sh. & s</u>			

7 CONTRACTOR'S OR LANDOWNER'S CERTIFICATION: This water well was (1) constructed, (2) reconstructed, or (3) plugged under my jurisdiction and was completed on (mo/day/year) _____ and this record is true to the best of my knowledge and belief. Kansas Water Well Contractor's License No. 300 This Water Well Record was completed on (mo/day/yr) 4-1-91 under the business name of John Kelly by (signature) [Signature]

OFFICE USE ONLY
T
R
EW
SEC