USE TYPEWRITER OR BALL POINT PEN-PRESS FIRMLY, PRINT CLEARLY.

T	R	EW	sec	1/4	1/4	1/4	No.			

WATER WELL RECORD
KSA 82a-1201-1215

Kansas State Dept. Of Health
(Water Well Contractors)
Forbes-Bldg. 740
Topeka, Kansas 66620

SE¼ NW¼ SW¼

1 Location of well:	County: Hamilton	Township name	Fraction: ~~SW¼~~	Section number: 8	Town number: 24	Range number: 40

Distance and direction from nearest town or city: East of Syracuse ½ mile
Street address of well location if in city:

3 Owner of well: Earl Hinton
Address: Syracuse 67878

Locate with "X" in section below:

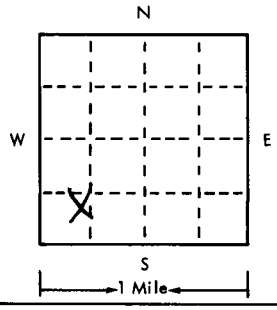

Sketch map:

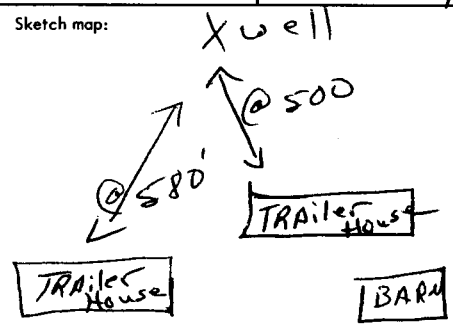

4 Well depth: 255 ft. Date of completion 5-30-77
Well diameter 7 7/8 in.

5 ☐ Cable tool ☒ Rotary ☐ Driven ☐ Dug
☐ Hollow rod ☐ Jetted ☐ Bored ☐ Reverse rotary

6 Use: ☒ Domestic ☐ Public supply ☐ Industry
☐ Irrigation ☐ Air conditioning ☐ Commercial
☐ Test well ☐ _____

7 Casing: Material PVC Height: above/below
Threaded ☐ Welded ☐ Surface 24 in.
Diam. 5 in. to 255 ft. depth Weight _____ lbs./ft.
_____ in. to _____ ft. depth Drive shoe? ☐ Yes ☐ No

2

Type and color of material	From	To
overburden & Sand	0	31
Blue Shale	31	213
Dakota Sand	213	255
(use a second sheet if needed)		

8 Screen:
Manufacturer Jah
Type PVC Dia. 5
Slot/gauze 42 Length _____
Set between 213 ft. and 245 ft.
Fittings:
Gravel pack ☒ Yes ☐ No Size range of material Chip

9 Static water level:
213 ft. below land surface Date _____

10 Pumping level below land surfaces:
_____ ft. after _____ hrs. pumping _____ g.p.m.
_____ ft. after _____ hrs. pumping _____ g.p.m.
Estimated maximum yield 20 g.p.m.

11 Water sample submitted:
☐ Yes ☒ No Date _____

12 Well head completion:
☒ Pitless adapter 24 Inches above grade

13 Well grouted? ☒ Yes ☐ No
☒ Neat cement ☐ Bentonite ☐ _____
Depth: From 3 ft. to 31 ft.

14 Nearest source of possible contamination:
ft. 500 Direction S Type Sewer
Well disinfected upon completion? ☒ Yes ☐ No

15 Pump: ☐ Not installed
Manufacturer's name Goulds
Model number 13EM HP 1.5 Volts 220
Length of drop pipe 220 ft. capacity 13 g.m.p.
Type:
☒ Submersible ☐ Turbine
☐ Jet ☐ Reciprocating
☐ Certrifugal ☐ Other

16 Remarks: elevation

Topography:
☐ Hill
☐ Slope
☐ Upland
☒ Valley

17 Water well contractor's certification:
This well was drilled under my jurisdiction and this report is true to the best of my knowledge and belief.
Fulton Drilling 300
Business name License No.
Address Syracuse
Signed [signature] Authorized Representative Date 5-30-77
MNC

Forward the white, blue and pink copies to the Kansas State Dept. Of Health.

Form WWC-5

24 40 W 8 NW SW