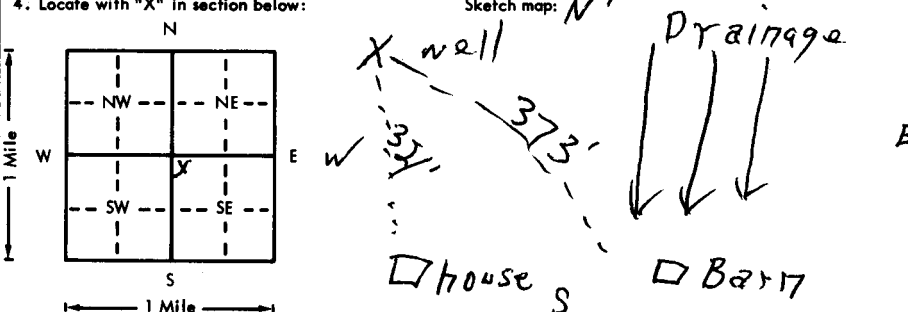


USE TYPEWRITER OR BALL POINT PEN—PRESS FIRMLY, PRINT CLEARLY.

WATER WELL RECORD  
KSA 82a-1201-1215

Kansas Department of Health and Environment—Division of Environment  
(Water well Contractors)  
Topeka, Kansas 66620

1. Location of well: County <u>Hamilton</u> Fraction <u>NW 1/4 NW 1/4 SE 1/4</u> Section number <u>8</u> Township number <u>T 24 S</u> Range number <u>R 40 E</u>	
2. Distance and direction from nearest town or city: <u>1 mi E</u> 3. Owner of well: <u>Henry Wells</u> Street address of well location if in city: <u>1/4 mi N of Syracuse</u> City, state, zip code: <u>Syracuse KS</u>	
4. Locate with "X" in section below: Sketch map: <u>N</u> 	
5. Type and color of material	
	From To
<u>Clay</u>	<u>0 20</u>
<u>Gravel</u>	<u>20 40</u>
<u>Shale</u>	<u>40 160</u>
<u>DeKota clay</u>	<u>160 180</u>
<u>Shale &amp; Sandstone</u>	<u>180 310</u>
6. Bore hole dia. <u>10</u> in. Completion date <u>5-29-76</u> Well depth <u>310</u> ft.	
7. <input checked="" type="checkbox"/> Cable tool <input checked="" type="checkbox"/> Rotary <input type="checkbox"/> Driven <input type="checkbox"/> Dug <input type="checkbox"/> Hollow rod <input type="checkbox"/> Jetted <input type="checkbox"/> Bored <input type="checkbox"/> Reverse rotary	
8. Use: <input checked="" type="checkbox"/> Domestic <input type="checkbox"/> Public supply <input type="checkbox"/> Industry <input type="checkbox"/> Irrigation <input type="checkbox"/> Air conditioning <input type="checkbox"/> Stock <input type="checkbox"/> Lawn <input type="checkbox"/> Oil field water <input type="checkbox"/> Other	
9. Casing: Material <u>RMP</u> Height: <u>Above</u> or below Threaded <input type="checkbox"/> Welded <u>9/16</u> Surface <u>24</u> in. RMP <input checked="" type="checkbox"/> PVC <input type="checkbox"/> Weight _____ lbs./ft. Dia. <u>5</u> in. to <u>310</u> ft. depth Wall Thickness: inches or Dia. _____ in. to _____ ft. depth gage No. <u>0320</u>	
10. Screen: Manufacturer's name <u>Jess Lowell</u> Type <u>Styrene</u> Dia. <u>5"</u> Slot gauge <u>1/16</u> Length <u>50</u> Set between <u>180</u> ft. and <u>200</u> ft. <u>280</u> ft. and <u>310</u> ft. Gravel pack? <u>Yes</u> Size range of material <u>3/16</u>	
11. Static water level: _____ mo./day/yr. <u>110</u> ft. below land surface Date <u>3-29-76</u>	
12. Pumping level below land surfaces: <u>150</u> ft. after <u>2</u> hrs. pumping <u>50</u> g.p.m. _____ ft. after _____ hrs. pumping _____ g.p.m. Estimated maximum yield <u>50</u> g.p.m.	
13. Water sample submitted: _____ mo./day/yr. Yes <input checked="" type="checkbox"/> No <input type="checkbox"/> Date _____	
14. Well head completion: <input checked="" type="checkbox"/> Pitless adapter <u>24</u> inches above grade	
15. Well grouted? <u>Yes</u> With: <input type="checkbox"/> Neat cement <input type="checkbox"/> Bentonite <input checked="" type="checkbox"/> Concrete Depth: From <u>24</u> ft. to <u>10</u> ft.	
16. Nearest source of possible contamination: ft. <u>321</u> Direction <u>S</u> Type <u>HOUSE</u> Well disinfected upon completion? <input checked="" type="checkbox"/> Yes <input type="checkbox"/> No	
17. Pump: <input checked="" type="checkbox"/> Not installed Manufacturer's name _____ Model number _____ HP _____ Volts _____ Length of drop pipe _____ ft. capacity _____ g.p.m. Type: <input type="checkbox"/> Submersible <input type="checkbox"/> Turbine <input type="checkbox"/> Jet <input type="checkbox"/> Reciprocating <input type="checkbox"/> Centrifugal <input type="checkbox"/> Other	
(Use a second sheet if needed)	
18. Elevation: Topography: <input checked="" type="checkbox"/> Hill <input type="checkbox"/> Slope <input type="checkbox"/> Upland <input type="checkbox"/> Valley	19. Remarks: <b>Concrete slab to be installed by customer at surface of ground. He knows this is a regulation.</b>
20. Water well contractor's certification: This well was drilled under my jurisdiction and this report is true to the best of my knowledge and belief. <u>High Plains Drilling Supply</u> Business name _____ License No. _____ Address <u>402 N 3rd</u> B134 Signed <u>Dustin Palmora</u> Date <u>6-27-76</u> Authorized representative	

T 24 S R 40 E  
Sec 8 NW 1/4 SE