USE TYPEWRITER OR BALL POINT PEN-PRESS FIRMLY, PRINT CLEARLY.

T	R	EW	sec 1/4	1/4	1/4 No.					

WATER WELL RECORD
KSA 82a-1201-1215

Kansas State Dept. Of Health
(Water Well Contractors)
Forbes-Bldg. 740
Topeka, Kansas 66620

1 Location of well:	County	Township name	Fraction	Section number	Town number	Range number
	Hamilton	Mayline	NE corner	13	24	40

Distance and direction from nearest town or city:

Street address of well location if in city:

3 Owner of well: CARL Thomeczek

Address: Syracuse

Locate with "X" in section below: Sketch map:

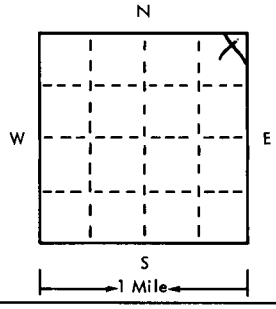

4 Well depth: 221 ft. Date of completion 2-24-75
Well diameter 5 in.

5 ☐ Cable tool ☑ Rotary ☐ Driven ☐ Dug
☐ Hollow rod ☐ Jetted ☐ Bored ☐ Reverse rotary

6 Use: ☑ Domestic ☐ Public supply ☐ Industry
☐ Irrigation ☐ Air conditioning ☐ Commercial
☐ Test well ☐ _____

7 Casing: Material PLASTIC Height: above/below
Threaded ☐ Welded ☐ Surface 12 in.
Diam. 5 in. to 221 ft. depth Weight 250 lbs./ft.
___ in. to ___ ft. depth Drive shoe? ☐ Yes ☑ No

2

Type and color of material	From	To
0-30 overburden & clay	0	30
30-158 Blue shale	30	158
Dakota Sand	158	185
Gray shale	185	201
Dakota Sand	201	220
Gray shale	220	221
(use a second sheet if needed)		

8 Screen:
Manufacturer _____
Type drilled Dia. 5/32
Slot/gauze _____ Length _____
Set between 181 ft. and 221 ft.
Fittings:
Gravel pack ☒ Yes ☐ No Size range of material ___

9 Static water level:
150 ft. below land surface Date 2-25-75

10 Pumping level below land surfaces:
___ ft. after ___ hrs. pumping ___ g.p.m.
___ ft. after ___ hrs. pumping ___ g.p.m.
Estimated maximum yield 50 g.p.m.

11 Water sample submitted:
☐ Yes ☑ No Date _____

12 Well head completion:
☐ Pitless adapter ☑ 12 inches above grade

13 Well grouted? ☒ Yes ☐ No
☒ Neat cement ☐ Bentonite ☐ _____
Depth: From 0 ft. to 20 ft.

14 Nearest source of possible contamination:
ft. _____ Direction _____ Type _____
Well disinfected upon completion? ☑ Yes ☐ No

15 Pump: ☐ Not installed
Manufacturer's name Gould
Model number _____ HP 1 Volts 230
Length of drop pipe 185 ft. capacity 12 g.m.p.
Type:
☒ Submersible ☐ Turbine
☐ Jet ☐ Reciprocating
☐ Certrifugal ☐ Other

16 Remarks: elevation

Topography:
☐ Hill
☐ Slope
☐ Upland
☒ Valley

17 Water well contractor's certification:
This well was drilled under my jurisdiction and this report is true to the best of my knowledge and belief.
Fulton Drilling Co 300
Business name License No.
Address Syracuse, Ks.
Signed [signature] Date 7-28-75
Authorized representative

Forward the white, blue and pink copies to the Kansas State Dept. Of Health.

Form WWC-5